	State W	ell Report	
County: TACKSON		art 1	For Office Use Only:
-		t of Environmental Quality	Aquifer:
Permit #:	Office of Land and Water Resources P.O. Box 10631		Well #:
Driller: Coast Water Well SN		S 39289-0631	L. S. Elevation:
Date drilling completed: $2 - 1 - 07$	(601)961-5210 (601)354-6938 (fax)		E-log #:
State Law requires that this repo		driller in detail and filed w	ith the Department with
30 days of completion of drilling Well Owner Informa		Wei	Location
Owner Name Richard Franovich		Latitude: 30.30,22	" Longitude: 088º 44,8
Mailing Address: 5317 Old MObile HWY.		40 .11 Method of Lat/Long (circle or	
		USGS quad, Hand-heid GPS, Survey-grade GPS	
Pascagoula, MS 39581 City State Zip Code		SE 1/ NE 1/4 Sec 30	
Telephone No. (208) 218 - 5349		Distance Direction Nearest Town <u>2</u> Miles <u>NW</u> of <u>Hureley</u>	
	Well D	Jata	
If flowing, method of flow regulation: Val Static Water Level: $\underline{40}$ feet ab Method of Measurement (circle one) sto Hole depth: $\underline{360'}$ Well dep	ove of below (circle one) la eel tape electric tape		
Type of grout (circle one): Cement 200'-4'' Casing length: $140'-2''$ feet Casin			
Screen length: <u>AO</u> feet Scree	en diameter:	inches Type of screen:	PVC
Screen slot size:	Setting depth: From	<u>340</u> feet to	<u>360</u> feet
Type of completion (circle all applicable):			
Top of lap pipe or reduction in casing:	I feet. If tel	escoped or more than one scre	een, describe on back of pag
Logs run (circle all applicable): No log run	) Electric Gamma Ray	Density Sonic Neutron	Other:
Name of organization running log(s):	ucted, and completed in a	ccordance with all applicable	requirements of the Missis

)-250


If well telescopes please sketch below and show depths.

Ground Level

`**•**, '

Description of Formations Encountered	From	To
 TOP SOIL Orange Clay	10	10/
Blue Clay Wistreaks of sand Gray Coarse Sarid	80	315
		<u> </u>
	<u> </u>	<u> </u> ]
	<u>†</u>	

If more than one screen, show location of each on sketch

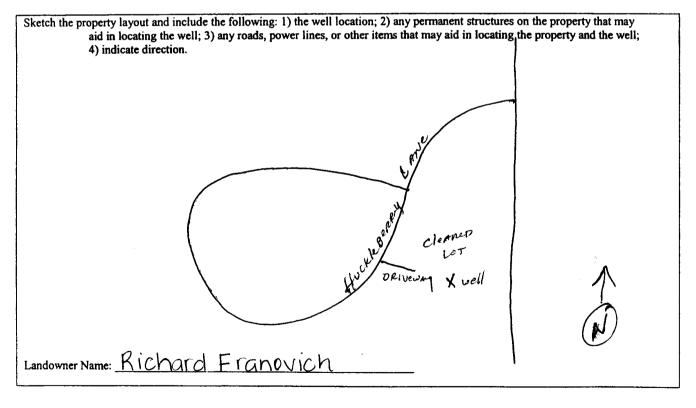

Jul

Signature of Water Well Contractor

RECEIVED Fex 18 200 GN CENSE

		ELL REPORT	
County: <u>JACKSON</u> Permit #: Driller( <u>Dast Water Wt</u> Date completed: <u>2 - 1 - 0</u>	Pump Installer   Mississippi Departme   Office of Land   P.O.   Jackson, J   7	Part 2 Pump Installer's Completion Report Mississippi Department of Environmental Quality Office of Land and Water Resources P.O. Box 10631 Jackson, MS 39289-0631 (601)961-5210 (601)354-6938 (fax)	
installation of pump.	pared by the pump installer in det		
	r Information		l Location
Owner Name: Richard Franovich		Latitude: 30 30 221"	Longitude: <u>088°46'866</u> ne): Conventional Survey,
Mailing Address: 5317 DID MUBILE HWY.		Method of Lat/Long (circle on	e): Conventional Survey,
		USGS quad, Hand	-held GPS, Survey-grade GPS
Pascagoula, MS 39581 City State Zip Code		SE 1/4 NE 1/4 Sec 30	5_Twn 745 Rng R.5W
			Nearest Town
Telephone No. (298) 218	-5349	2 Miles NW of	E Hurley
Pum	ир Турс	Pov	wer Type
Circ	cle one	Ci	rcle one
Air Lift Jet	Submersible	Diesel Engine Gasolin	e Engine Natural Gas
Bucket Piston	Turbine	Electric Motor Hand	Tractor PTO
Centrifugal Rotary	y Flowing Well	Windmill Other (	specify):
Other (specify):		Horse Power Rating of Motor:	attp
Date Pump Installed: 2-3	5-07	Setting Depth: JaD Ft. C	TOP PIPE feet
Rated Pump Capacity:2	Gallons Per Minute	Number of Stages:	· 4
Pump	Test Data		Isuring Water Level
Date Well Tested:	)-07		rcle one
Static Water Level (A): 41	Feet Below Land Surface		suring Line Steel Tape
Pumping Water Level (B):	A Feet Below Land Surface	Other (specify):	
Drawdown [(B) - (A)]:		For flowing well, measured shu	ut in head: NIA feet
Test Pumping Rate:28 Gallons Per Minute		Well yielded $28$ GPM with a drawdown of	
Test Pumping Rate:			N A hours of pumping

· · ·