State V	Vell Report		
14.11.2.20	Driller's Log	For Office Use Only:	
Minini	ent of Environmental Quality	quifer:	
Office of Land	Office of Land and Water Resources		
	Box 10631	Vell #: 1-282	
Jackson	MS 20200 0621	. S. Elevation:	
liste drilling commisted	(601)961-5210		
	(601)354-6938 (fax) E-log #:		
State Law requires that this report be prepared by the li Department at the above address within 30 down of some			
and above dualess within 50 days of com	pletion of drilling of the well or	work and filed with the borehole.	
into mation on wen Owner	Well or Boreh	ole Location	
(Landowner if borehole is not for a water welly		2 00 101	
Owner Name_Nerely Voluter Fire Sept	Latitude: <u>08 ° 29 '55(</u> " I		
Aailing Address: Au 613 South Method of Lat/Long (circle one): Conventional Survey,			
0	USGS quat. Hand-held GP	S Survey-grade GPS	
*/ /	500 1/ DE 1/4 Sec_33	VEV.EN	
Nauly Mrs 39562	74 Sec	Iwn 1 Rng DW	
City J State Zip Code	Distance Direction	Nearest Town	
Telephone No. ()	Miles of	IN Hurley, MD	
		9	
Well / Bor Date drilling started: 9407 Date drilling completed: 9497 Location of the source of any surface water used for drilling:	Hole depth: Ho	le diameter: 2	
Method of dosing and volume of Chlorine used in drilling and deve	Topment: upper delom	200 Welly	
Logs run (circle all applicable) No log run Electric Gamma Ray Name of organization running log(s):	Density Sonic Neutron Othe		
Purpose of borehole (check one): Water Well Geotechnical/Geol	ogical Investigation Ground Sou	rce Heat Pump	
Seismic Survey Other (describe)	D. CTR. EN	
If drilling is not related to water well construction	n, skip the remainder of this block	SV. 22002	
Purpose of Well (check one): HomeIndustrial Public Supply		Dther:	
If a flowing well, method of flow regulation: Valve C	ther (describe)	R	
Static Water Level: feet above (below circle one)	and surface Date measured:	7-4-07	
Method of Measurement (circle one) steel tape electric tape			
Well depth: <u>310</u> Well grouted to a depth of <u>10</u> feet Type	of grout (circle one): Neat Cemen	Bentonite Mix	
	_inches Type of casing:		
Screen length: 10feet Screen diameter:	_inches Type of screen: Sc	h 30 (1	

Screen slot size: 6 inches Setting depth: From 6 feet to 310 feet Type of completion (circle all applicable): Gravel packed Underreamed Telescoped Open hole Natural Development

_feet. If telescoped or more than one screen, describe on next page

Other (describe): _


Top of lap pipe or reduction in casing:

Form: OLWR-SWR-1A

)-282

	Ŷ		
Description of formations encountered	must be provided	for ali	
wells and boreholes, unless specifically exempted by regulations			
		ataccons	
Description of Formations Encountered	From (depth)	To (depth)	
		+	
1 0		+	
White Sand	\sim	55	
	+	23	
ΩΛ Λ		<u>+</u>	
Blue clan	55	250	
0			
		+	
Sher And	250	310	
	10.00		
	1		
		1	
		<u> </u>	
		1	
	wells and boreholes, unless specifically Description of Formations Encountered utile Sand Blue Clay	Ground Level utile sand Blue clay 55	

If more than one screen, show location of each on sketch

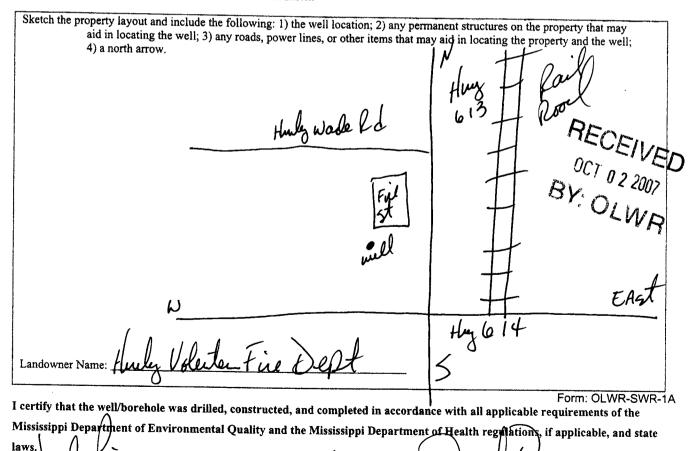

del 1 m 6-180 9-4-07

Signature of Licensee

Print Name of Responsible Licensee and License No.

Date

, STATE WELL REPORT				
County: $aclson$ Permit #: $0 - 780$	Part 2 Pump Installer's Completion Report Mississippi Department of Environmental Quality		For Office Use Only: Aquifer:	
Driller: W. Jce Pierce Date completed: 9-4-07	Office of Land and Water Resources P.O. Box 10631 Jackson, MS 39289-0631		Well #: D - 282	
Copy information from block on Part 1	· · ·	961-5210 4-6938 (fax)	Elevation:	
This part of the report must be completed by a licensed water well contractor or a licensed pump installer. A copy of Part 1 of the report must be attached and both parts filed with the Department at the above address within 30 days of well completion.				
Well Owner Information		Well Location		
Owner Name: Hule Volute	Firlipt	Latitude: <u>88-74-551</u>	Longitude: <u>30-38-471</u>	
Mailing Address: Hg 6/3	Method of Lat/Long (ct		ck one): Conventional Survey	
		USGS quad, Hand-held	GPS, Survey-grade GPS	
Hule us City State	<u>3556</u> 2 Zip Code	5W 1/4 NE 1/4 Sec 33	3_ <u>τ</u> 45_ <u>R</u> 5ω	
	Dip Cold	Distance Direction	Ncarcst Town	
Telephone No. ()		Miles with of	Huly, MD	
Pump Type		Pos	ver Type	
Circle one			rcle one	
Air Lift Jet	Submersible	Diesel Engine Gasolin	e Engine Natural Gas	
Bucket Piston	Turbine	Electric Motor Hand	Tractor PTO	
Centrifugal Rotary	Flowing Well	1 -	specify):	
Other (specify):		Horse Power Rating of Motor: Setting Depth: 60 FT fet line for 1 02 2007 Number of Stages: 2 BY 02 2007		
Date Pump Installed: $9 - 4 - 07$)	Setting Depth:60 +	7 Set line of FIVE	
Rated Pump Capacity:	Fallons Per Minute	Number of Stages: 2	BYOLING	
Pump Test Data	*******		asuring Water Level	
Date Well Tested: <u>9-4-07</u>			rcle one	
Static Water Level (A):Feet B	elow Land Surface		suring Line Steel Tape	
Pumping Water Level (B): <u>60</u> Feet Be	elow Land Surface	Other (specify):		
Drawdown [(B) - (A)]:Feet Below Land Surface		For flowing well, measured sh	ut in head:feet	
Test Pumping Rate:O	allons Per Minute Well yielded GPM with a drawdown of			
Duration of Pump Test (minimum 4 hours):	<u>48</u> hours	feet after	-	
I HEREBY CERTIFY that the above statements are true to the best of my knowledge.				

Print Name of Pump Installer and License No. (if applicable)

-

3

.

Signature of Pump Installer