	State Well Report	
County: Jackson	Part 1 – Driller's Log	For Office Use Only:
Permit #: $O - 780$	Mississippi Department of Environmental Quality	Aquifer:
Driller: W. Jael Pierc	Office of Land and Water Resources P.O. Box 10631	Well #: D-287
Date drilling completed: 10-7-07	Jackson, MS 39289-0631 (601)961-5210	L. S. Elevation:
	(601)354-6938 (fax)	E-log #:

٤


Information on Wall Owner	
Information on Well Owner (Landowner if borehole is not for a water well)	Well or Borehole Location
Owner Name_John Filman	Latitude: <u>88 ° 30 ' 866</u> " Longitude: <u>30 ° 39 ' 964</u> "
Mailing Address: Lott 11	Method of Lat/Long (circle one): Conventional Survey,
Quail flidge Sub	USGS quad Hand-held GPS_Survey-grade GPS
Hunly ms 39562	5 4 1 W 1/4 Sec 30 Twn 45 Rng 5 W
City State Zip Code Telephone No. (28)327 - 5290	Distance Direction Nearest Town <u>Z</u> Miles <u>Mu</u> of <u>Hung</u> us
	7
Well / Bore	hole Data
Date drilling started: 10-7-07 Date drilling completed: 10-7-0	7 Hole depth: <u>80</u> Hole diameter: <u>2</u>
Location of the source of any surface water used for drilling: Method of dosing and volume of Chlorine used in drilling and devel	opment: Agel chilor 2000 water
Logs run (circle all applicable): No log run Electric Gamma Ray Name of organization running log(s):	Density Sonic Neutron Other:
Purpose of borehole (check one): Water Well Geotechnical/Geol	ogical Investigation Ground Source Heat Pump
Seismic Survey Other (describe If drilling is not related to water well constructio) n, skip the remainder of this block
Purpose of Well (check one): Home Public Supply	Irrigation Fish Culture Other:
If a flowing well, method of flow regulation: Valve O	ther (describe)
Static Water Level: feet above or below (circle one)	and surface Date measured: $10 - 7 - 07$
Method of Measurement (circle one) steel tape electric tape	air line other:
Well depth: <u>80</u> Well grouted to a depth of <u>10</u> feet Type	
Casing length: <u>70</u> feet Casing diameter: <u>2</u>	
Screen length: <u>10</u> feet Screen diameter: <u>2</u>	inches Type of screen: 80
Screen slot size: inches Setting depth: From	0 feet to <u>80</u> feet 10Fact casing 70Fact casing
Type of completion (circle all applicable): Gravel packed Under	10 Fut casing 70 Fut casing reamed Telescoped Open hole Natural Development
Other (describe):	
Top of lap pipe or reduction in casing:feet. If te	lescoped or more than one screen, describe on next page
	RECEIVED Form: OLWR-SWR-1A

OCT 3 1 2007 BY: OLWR

D-297

well telescopes, show depths on sketch.	Description of formations encountered must be provided for all wells and boreholes, unless specifically exempted by regulations		
Ground Level	Description of Formations Encountered		To (depth
		Ground Level	
	white new	0	30
	yellow clay	30	40
	mate save	40	80
			<u> </u>

If more than one screen, show location of each on sketch

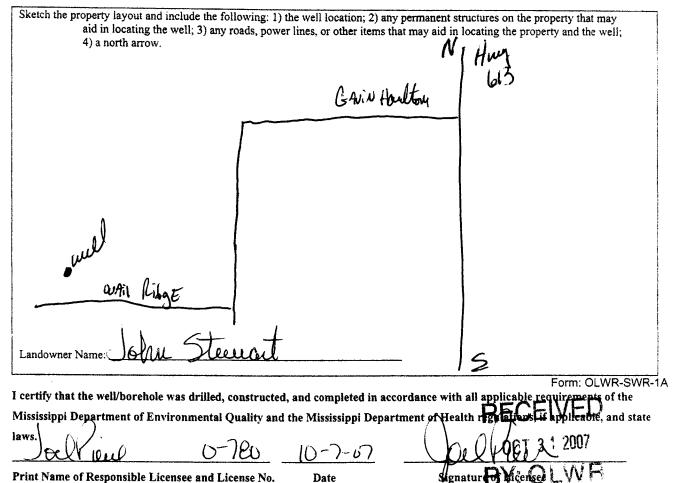

Print Name of Responsible Licensee and License No.

Date

. /	STATE W	ELL REPORT		
County: action	-	Part 2	For Office Use Only:	
Permit #: $0 - 780$	Pump Installer's Completion Report Mississippi Department of Environmental Quality Office of Land and Water Resources P.O. Box 10631 Jackson, MS 39289-0631		Aquifer:	
Driller: W. Jcel Pierce			Well #: D-28?	
Date completed: _/0-7-07				
)961-5210 54-6938 (fax)	Elevation:	
Copy information from block on Part 1]			
This part of the report must be completed report must be attached and both parts fil				
Well Owner Information			Location	
Owner Name: John Stewart	+	Latitude: <u>98 - 30 - 366</u>	Longitude: <u>30 · 39 - 964</u>	
Mailing Address: Lott 11		Method of Lat/Long (check one): Conventional Survey,		
Quail Rick	1 Sub	USGS quad, Hand-held	GPS , Survey-grade GPS	
terle no City State	<u>39562</u> Zip Code	<u>SE 1/4 MW 1/4 Sec 30</u>	0 T 45 R 500	
City State	Lip Code	Distance Direction	Ncarest Town	
Telephone No. (208) 327 - 5290		2 Miles MW of Hule My 5		
D				
Pump Type Circle one			wer Type ircle one	
Air Lift Jet	Submersible	Diesel Engine Gasolin	e Engine Natural Gas	
Bucket Piston	Turbine	Electric Motor Hand	Tractor PTO	
Centrifugal Rotary	Flowing Well	Windmill Other (specify):	
Other (specify):		Horse Power Rating of Motor:		
Date Pump Installed: (0-)-07)	Setting Depth: 40 fe	t line feet	
Rated Pump Capacity: ()	Gallons Per Minute	Number of Stages: Z		
Pump Test Data		Method of Me	asuring Water Level	
Date Well Tested: 10.7-07			rcle one	
Static Water Level (A):Feet	(Air Line Electric Mean	suring Line Steel Tape	
Pumping Water Level (B): <u>40</u> Feet		Other (specify):		
Drawdown [(B) - (A)]:Feet	Below Land Surface	For flowing well, measured sh	ut in head:feet	
Test Pumping Rate: 10	Gallons Per Minute	Well yielded	_GPM with a drawdown of	
Duration of Pump Test (minimum 4 hours):	<u>48</u> hours	feet after	48hours of pumping	
			RECEIVED	
I HEREBY CORTIFY that the above statem	then the true to the best of -780	of my knowledge.	OCT 3 1 2007	
Print Name of Pump Installer and License N	lo. (if applicable)	Signature of Pump In	staller: OMR	

2

4

2

Form:	OLW	R-SWR-1	B