State V	Vell Report			
	Part 1	For Office Use Only:		
MISSISSIDDI Departine	nt of Environmental Quality	Aquifer:		
	and Water Resources Box 10631	well #: <u>D-292</u>		
Driller WET WELLSKY Jackson,	MS 39289-0631	L. S. Elevation:		
)961-5210 54-6938 (fax)	E-log #:		
State Law requires that this report be prepared by th 30 days of completion of drilling of the well.				
Well Owner Information	1	Location		
Owner Name_Mike, Sparks	Latitude: $30 \cdot 41 \cdot 595$	" Longitude <u>088 • 28 · 730</u> " ne): Conventional Survey,		
Mailing Address: 24108 Hinton Fd.	Method of Lat/Long (circle or	ne): Conventional Survey, 77		
	USGS quad, Hand-held	GPS Survey-grade GPS		
MOSE Point Ms 39562- City State Zip Code		Twn <u>T4S_RngR5W</u>		
Telephone No. 208, 588 -9496	- Distance Direction Newson Tours			
Weil	Data			
Purpose of Well (circle one) Home Industrial Public Supply Irrigation Fish Culture Other:				
Date well drilling started: Date				
If flowing, method of flow regulation: Valve A Other (describe)			
Static Water Level:feet above or below circle one)	land surface Date measured:_	11-15-07		
Method of Measurement (circle one) steel tape electric tap	\smile $-$	1		
Hole depth: <u>61FT</u> Well depth: <u>61FT</u>	_ Well grouted to a depth of	_/Ofeet		
Type of grout (circle one): Cement Bentonite Mix				
Casing length: <u>51</u> feet Casing diameter: <u>A</u> inches Type of casing: <u>PVC</u>				
Screen length: 10 feet Screen diameter:	inches Type of screen:	FVC		
Screen slot size:				
Type of completion (circle all applicable): Gravel packed Underreamed Telescoped Open hole Natural Development				
Other (describe):				
Top of lap pipe or reduction in casing:				
Logs run (circle all applicable): No log run Electric Gamma Ray	Density Sonic Neutron (Other:		
Name of organization running log(s): NA I certify that the well was drilled, constructed, and completed in	accordance with all amplicable			
Department of Environmental Quality and/or the Mississippi De				
Tock Didadell 0-1172	() , Ral	luc		
Print Name of Water Well Contractor and License No.	Lint Norma of Water Wall Company of U.			
This realie of water wen contractor and License No.	// Signature of V	Water Well Contractor		

BATOFAAB OELINE 3224

D-292

If well telescopes please sketch below and show depths.


Ground Level

R

• •

	Description of Formations Encountered	From To
<u>,</u>	Top Soil Orange Clay	2 18
	prange Coarse Sand	18 61
	······································	

If more than one screen, show location of each on sketch

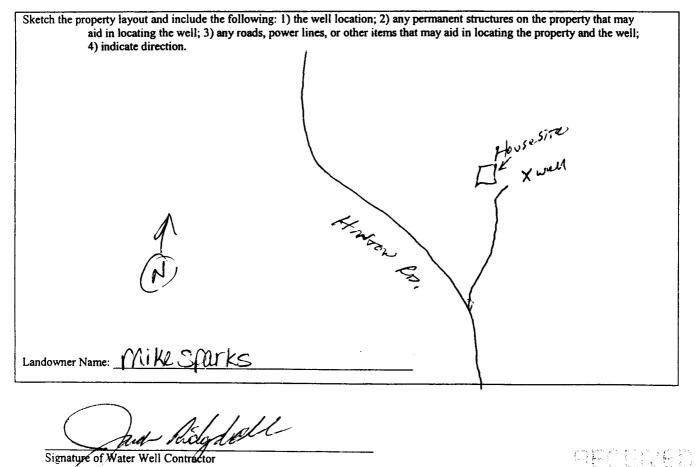

OEC 17 2007

BY OLWR

Date completed: 11-	<u>terwell</u> srv. 15-07	Pump Installer Mississippi Departme Office of Land P.O. Jackson, (60 (601)3	FELL REPORT Part 2 r's Completion Report ent of Environmental Quality i and Water Resources . Box 10631 MS 39289-0631 1)961-5210 354-6938 (fax) tail and filed with the Departme	For Office Use Only: Aquifer: Well #: <u>D-292</u> Elevation: ent within 30 days of the
installation of pu				ll Location
Owner Name:				 Longitude: <u>088 28' 7</u> 3
Mailing Address:				
Mailing Address:	HILLIG HILLIG		Method of Lat/Long (circle or	
	Coin I A	Ne 29517		d-held GPS Survey-grade GPS
Moss foint Ms 39562 City State Zip Code		50 1/2 SW 1/2 Sec_15 Twn T 45 Rng R.5 W		
		Distance Direction		
Telephone No. (138) 588-9496		<u></u>	st_thipkey	
	Pump Type			wer Type
	Circle one			ircle one
Air Lift	Jet	Submersible	Diesel Engine Gasolir	ne Engine Natural Gas
Bucket	Piston	Turbine	Electric Motor Hand	Tractor PTO
Centrifugal	Rotary	Flowing Well	Windmill Other	(specify):
Other (specify):				
Date Pump Installed: 11-16-07		Setting Depth: DADp pipe 40 feet		
Rated Pump Capacity:		Gallons Per Minute	Number of Stages:	
	Pump Test Data			asuring Water Level
Date Well Tested:	-16-01	·		
Static Water Level (A):Feet Below Land Surface		Air Line Electric Measuring Line Steel Tape		
Pumping Water Level	(B): <u>NA</u> Feet H	Below Land Surface	Other (specify):	····
	N/A Front	Below I and Surface	For flowing well, measured sh	ut in head:/A feet
	reel	Delow Land Suilace	<i>u</i> ,,	
Drawdown [(B) - (A)]	<u> </u>			GPM with a drawdown of
Drawdown [(B) – (A)] Test Pumping Rate: Duration of Pump Test	9	Gallons Per Minute	Well yielded	,
Drawdown [(B) (A)] Test Pumping Rate: Duration of Pump Test	9 (minimum 4 hours):	Gallons Per Minute	Well yielded	_GPM with a drawdown of
Drawdown [(B) (A)] Test Pumping Rate: Duration of Pump Test	(minimum 4 hours):	Gallons Per Minute	Well yielded	,
Drawdown [(B) – (A)] Test Pumping Rate: Duration of Pump Test HEREBY CERTIFY	(minimum 4 hours): that the above statemeters	Gallons Per Minute hours ents are true to the best of	Well yielded	NA hours of pumping
Drawdown [(B) – (A)] Test Pumping Rate: Duration of Pump Test HEREBY CERTIFY JACK Ridga	(minimum 4 hours): that the above statemeters	Gallons Per Minute hours ents are true to the best of	Well yielded N[Afeet after of my knowledge. fmich ////	NA hours of pumping

•