

County: Jackson
 Permit #: 0-780
 Driller: W. Joel Pierce
 Date drilling completed: 4-16-08

State Well Report
 Part 1 - Driller's Log

Mississippi Department of Environmental Quality
 Office of Land and Water Resources
 P.O. Box 10631
 Jackson, MS 39289-0631
 (601)961-5210
 (601)354-6938 (fax)

For Office Use Only:
 Aquifer: 305
 Well #: D-305
 L.S. Elevation: _____
 E-log #: _____

State Law requires that this report be prepared by the license holder responsible for the work and filed with the Department at the above address within 30 days of completion of drilling of the well or borehole.

Information on Well Owner <i>(Landowner if borehole is not for a water well)</i>	Well or Borehole Location
Owner Name: <u>Charles Nysaoul</u>	Latitude: <u>88° 31' 54.8" N</u> Longitude: <u>30° 41' 76.4" W</u>
Mailing Address: <u>Robert E Lee Drivl</u>	Method of Lat Long (circle one): <u>Hand-held GPS</u> , Survey-grade GPS
<u>Holly</u> <u>ms</u> <u>39562</u>	USGS quad: <u>5W 18 NW 45 Rng 5W</u>
City: _____ State: _____ Zip Code: _____	Distance: <u>4</u> Miles <u>Northw</u> of <u>Holly, ms</u>
Telephone No. <u>(228) 217-5317</u>	

Well / Borehole Data

Date drilling started: 4-16-08 Date drilling completed: 4-16-08 Hole depth: 330 Hole diameter: 2

Location of the source of any surface water used for drilling: Aquifer, ms
 Method of dosing and volume of Chlorine used in drilling and development: 2000 water 4 gal chlorine

Logs run (circle all applicable): No log run Electric Gamma Ray Density Sonic Neutron Other _____
 Name of organization running logs: _____

Purpose of borehole (check one): Water Well Geotechnical/Geological Investigation _____ Ground Source Heat Pump _____
 Seismic Survey _____ Other (describe) _____

If drilling is not related to water well construction, skip the remainder of this block

Purpose of Well (check one): Home Industrial _____ Public Supply _____ Irrigation _____ Fish Culture _____ Other: _____

If a flowing well, method of flow regulation: Valve _____ Other (describe) _____

Static Water Level: 3 feet above surface (circle one) land surface Date measured: 4-16-08

Method of Measurement (circle one): steel tape electric tape air line other: _____

Well depth: 330 Well grouted to a depth of 10 feet Type of grout (circle one): Neat Cement Bentonite Mix

Casing length: 310 feet Casing diameter: 2 inches Type of casing: Sch 40 Plastic

Screen length: 10 feet Screen diameter: 2 inches Type of screen: Sch 80

Screen slot size: 6 inches Setting depth: From 0 feet to 330 feet
10 screen 320 casing

Type of completion (circle all applicable): Gravel packed Underreamed Telescoped Open hole Natural Development
 Other (describe): _____

Top of lap pipe or reduction in casing: _____ feet. *If telescoped or more than one screen, describe on next page*

Form: OLWR-SWR-1A

RECEIVED
 MAY 14 2008
 BY: OLWR

D-305

The sketch below only required for water wells

If well telescopes, show depths on sketch.


Ground Level: →

Description of formations encountered must be provided for all wells and boreholes, unless specifically exempted by regulation.

Description of Formations Encountered	From depth	To depth
	Ground Level	
yellow sand	0	30
green clay	30	250
grey sand	250	330

If more than one screen, show location of each on sketch.

Sketch the property layout and include the following: 1) the well location; 2) any permanent structures on the property that may aid in locating the well; 3) any roads, power lines, or other items that may aid in locating the property and/or well; 4) a north arrow.

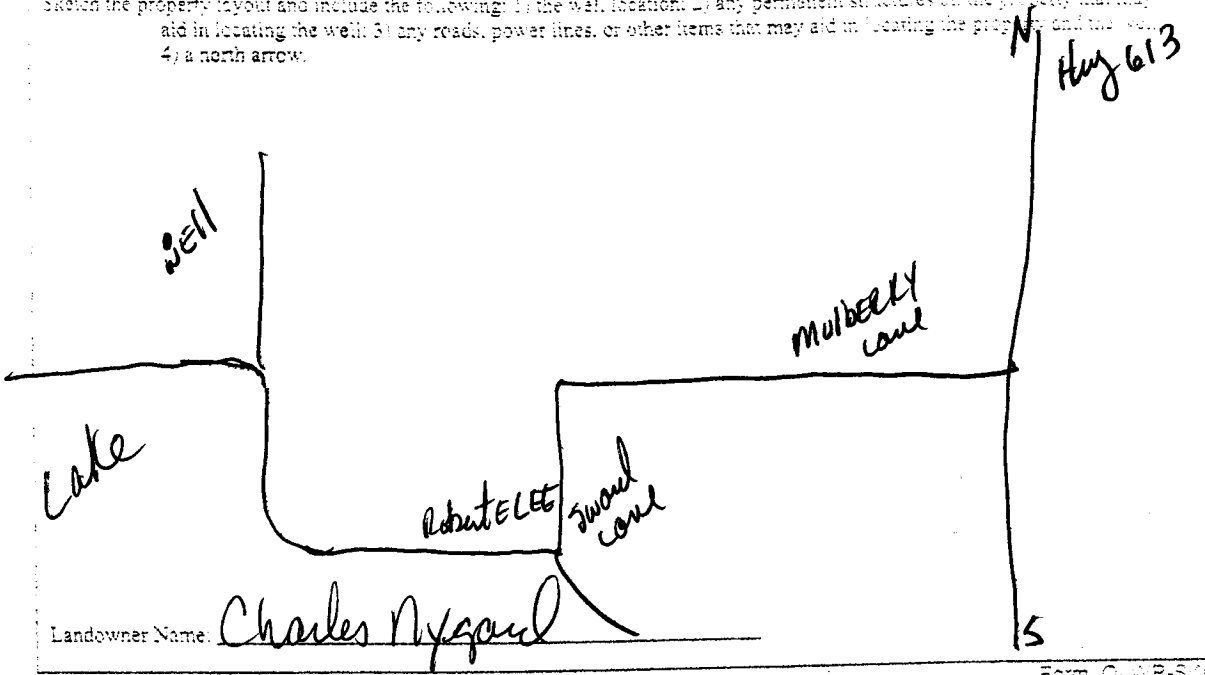

Landowner Name: Charles Nygaard

I certify that the well/borehole was drilled, constructed, and completed in accordance with all applicable requirements of the Mississippi Department of Environmental Quality and the Mississippi Department of Health regulations, if applicable, and state laws.

Joel Pierre 0-780 4-16-08

Signature of Licensee: Joel Pierre

Print Name of Responsible Licensee and License No.

Date

Signature of Licensee

RECEIVED

MAY 14 2008

BY: OLWR

STATE WELL REPORT

Part 2

Pump Installer's Completion Report
 Mississippi Department of Environmental Quality
 Office of Land and Water Resources
 P.O. Box 10631
 Jackson, MS 39289-0631
 (601)961-5210
 (601)354-6938 (fax)

County: Jackson
 Permit #: 0-780
 Driller: W. Joel Pierce
 Date completed: 4-16-08
Copy information from block on Part 1

For Office Use Only:

Aquifer: 305
 Well #: D-~~305~~
 Elevation: _____

This part of the report must be completed by a licensed water well contractor or a licensed pump installer. A copy of Part 1 of the report must be attached and both parts filed with the Department at the above address within 30 days of well completion.

Well Owner Information	Well Location
Owner Name: <u>Charles Nygaul</u>	Latitude: <u>88-31-544</u> Longitude: <u>30-41-764</u>
Mailing Address: <u>Robert E. Cee Drive</u>	Method of Lat/Long (check one): Conventional Survey _____ USGS quad _____ Hand-held GPS <input checked="" type="checkbox"/> Survey-grade GPS _____
<u>Huly</u> <u>ms</u> <u>39562</u> City State Zip Code	<u>SW</u> $\frac{1}{4}$ <u>NW</u> $\frac{1}{4}$ Sec <u>18</u> T <u>4S</u> R <u>5W</u>
Telephone No. <u>(228) 217-5317</u>	Distance Direction Nearest Town <u>4</u> Miles <u>NW</u> of <u>Huly, ms</u>

Pump Type Circle one	Power Type Circle one
Air Lift <input checked="" type="radio"/> Jet Submersible	Diesel Engine Gasoline Engine Natural Gas
Bucket: Piston Turbine	<input checked="" type="radio"/> Electric Motor Hand Tractor PTO
Centrifugal: Rotary Flowing Well	Windmill Other (specify): _____
Other (specify): _____	Horse Power Rating of Motor: <u>1</u>
Date Pump Installed: <u>4-16-08</u>	Setting Depth: <u>80 Jet line</u> feet
Rated Pump Capacity: <u>10</u> Gallons Per Minute	Number of Stages: <u>2</u>

Pump Test Data	Method of Measuring Water Level Circle one
Date Well Tested: <u>4-16-08</u>	<input checked="" type="radio"/> Air Line Electric Measuring Line Steel Tape
Static Water Level (A): <u>3</u> Feet Below Land Surface	Other (specify): _____
Pumping Water Level (B): <u>80</u> Feet Below Land Surface	For flowing well, measured shut in head: _____ feet
Drawdown [(B) - (A)]: <u>2</u> Feet Below Land Surface	Well yielded <u>10</u> GPM with a drawdown of
Test Pumping Rate: <u>10</u> Gallons Per Minute	<u>2</u> feet after <u>48</u> hours of pumping
Duration of Pump Test (minimum 4 hours): <u>48</u> hours	

I HEREBY CERTIFY that the above statements are true to the best of my knowledge.

JOEL PIERCE 0-780
 Print Name of Pump Installer and License No. (if applicable)

Joel P.
 Signature of Pump Installer

Form: OLWR-SWR-1E

RECEIVED

MAY 14 2008

BY: OLWR