	State Well Report	ſ <u></u>			
County: Jackson	Part 1 – Driller's Log	For Office Use Only:			
l M	ississippi Department of Environmental Quality	Aquifer:			
Permit #: 0-780	Office of Land and Water Resources P.O. Box 2307	Well #: D - 308			
Driller: Jollyw	Jackson, MS 39225				
Date drilling completed: 6-39-05	(601)961- 5210	L. S. Elevation:			
Date drilling completed:	(601)961- 5228 (fax)	E-log #:			
State I am requires that this report he	nuananad hy the liceuse holder resnansible for	<b>-</b>			
State Law requires that this report be prepared by the license holder responsible for the work and filed with the Department at the above address within 30 days of completion of drilling of the well or borehole.					
Information on Well Own		orehole Location			
(Landowner if borehole is not for a	water well)	" · · · · · · · · · · · · · · · · · · ·			
Owner Name John Walt	non Latitude: 00 94 312	_" Longitude: 30 ° 52 '311 "			
	Method of Lat/Long (circle of	ne): Conventional Survey,			
Mailing Address: 1204 Hex 6 1	4	<u> </u>			
0		GPS, Survey-grade GPS			
1///	29512 NE 15E 1/ Sec 31	Twn 45 Rng 5W			
Hub No	<u> </u>	,			
City U State	Zip Code Distance Direction  2 Miles	Nearest Town			
Telephone No. (228) 588 - 68	63	01 /11/20			
	Well / Borehole Data				
Date drilling started: 6-29 Date drillin	g completed: 5-29-08 <sub>Hole depth</sub> : 70	Hole diameter:			
Location of the source of any surface water us	ed for drilling: Agelle, and development: 4 cle	bru 2000 up to			
Method of dosing and volume of Chlorine us	ed in drilling and development:	total zoos voor i			
	Electric Gamma Ray Density Sonic Neutron				
Name of organization running log(s):					
Purpose of borehole (check one): Water Well	Geotechnical/Geological Investigation Ground	i Source Heat Pump			
Purpose of borehole (check one): Water Well Geotechnical/Geological Investigation Ground Source Heat Pump					
Seismic Surv	vey_Other (describe)	look			
If drilling is not related to water well construction, skip the remainder of this block					
Purpose of Well (check one): HomeIndus	strial Public Supply Irrigation Fish Culture	Other:			
If a flowing well, method of flow regulation: Valve Other (describe)					
Static Water Level:					
Method of Measurement (circle one) steel tape electric tape air line other:					
Well depth: 70 Well grouted to a depth of 16 feet Type of grout (circle one): Neat Cement Bentonite Mix					
Casing length: 360 feet Casing d	iameter:inches Type of casing:	set to Plat			
Screen length: 10 feet Screen d	liameter:inches Type of screen:	5ch 30			
Screen slot size: 6 inches	Setting depth: From feet to	70 feet			
Type of completion (circle all applicable):		hore Natural Development			
Other (describe):					
Top of lap pipe or reduction in casing:	feet. If telescoped or more than one scre	en, describe on next page			

Form: OLWR-SWR-1A (04/08)

## The sketch below only required for water wells


If well telescopes, show depths on sketch.

Ground Level

<u>Description of formations encountered must be provided for all</u> wells and boreholes, unless specifically exempted by regulations

Description of Formations Encountered	From (depth)	To (depth)
	Ground Level	
Λ		
		15
THE YOME	0	15
Med som	15	70
MANUTE AND THE STATE OF THE STA		
	ļ	ļ
		ļ
	1	
		<del></del>
	<del> </del>	<del>                                     </del>
		<u> </u>

If more than one screen, show location of each on sketch

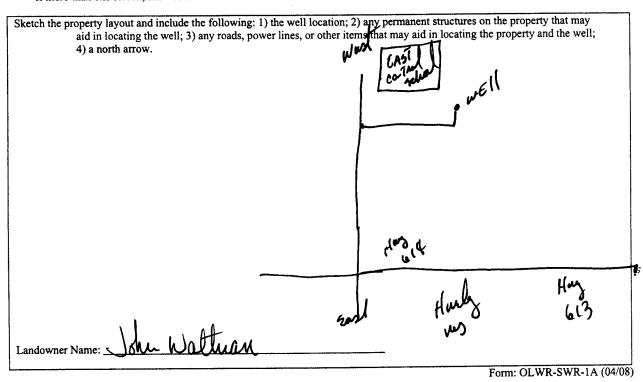

I certify that the well/borehole was drilled, constructed, and completed in accordance with all applicable requirements of the Mississippi Department of Environmental Quality and the Mississippi Department of Health regulations, if applicable, and state laws.

Print Name of Responsible Licensee and License No.

Date

Signature of Licensee

## STATE WELL REPORT

## Part 2

**Pump Installer's Completion Report** Mississippi Department of Environmental Quality Office of Land and Water Resources

P.O. Box 2309 Jackson, MS 39225 (601)961-5210

For Office Use Only:				
Aquifer:				
Well #:	D-309			
Elevation	n:			

(601)961-5228 (fax) Copy information from block on Part 1 This part of the report must be completed by a licensed water well contractor or a licensed pump installer. A copy of Part 1 of the report must be attached and both parts filed with the Department at the above address within 30 days of well completion. Well Location Well Owner Information Latitude: 88-44-512 Longitude: 30 52 311 Owner Name:\_c Method of Lat/Long (check one): Conventional Survey\_ Mailing Address: USGS quad\_\_\_\_, Hand-held GPS\_\_\_, Survey-grade GPS\_\_\_ Distance Direction Telephone No. (228) - 598 - 6863 Power Type Pump Type Circle one Circle one Natural Gas Gasoline Engine Diesel Engine Air Lift Submersible Jet Tractor PTO Electric Motor Hand Piston Turbine Bucket Other (specify): Flowing Well Windmill Centrifugal Rotary Horse Power Rating of Motor: Other (specify): \_ 6-29-08 Setting Depth: Date Pump Installed: 20 Number of Stages: Gallons Per Minute Rated Pump Capacity: \_ Method of Measuring Water Level Pump Test Data Circle one 5-29-08 Date Well Tested: Electric Measuring Line Steel Tape Air Line Feet Below Land Surface Static Water Level (A): Other (specify): Pumping Water Level (B): 50 \_\_Feet Below Land Surface For flowing well, measured shut in head: \_\_\_\_ Feet Below Land Surface Drawdown [(B) - (A)]: \_\_\_ 20 GPM with a drawdown of 20 Well vielded \_\_\_ Gallons Per Minute Test Pumping Rate: \_\_\_ feet after \_\_hours of pumping Duration of Pump Test (minimum 4 hours): \_\_\_

I HEREBY CERTIFY that the above	statements are true to the best of $0-780$	my knowledge.	
Print Name of Pump Installer and License No. (if applicable)		Signature of Pump Installer	
		Form: OLWR-SWR-1	B (04/08)