State Well Report						
Part 1	For Office Use Only:					
Mississippi Department of Environmental Quality	Aquifer:					
Permit A: Office of Land and Water Resources P.O. Box 10631	Well #:					
Driller LIF of Watch Wall Dr. Jackson, MS 39289-0631	L. S. Elevation:					
Date drilling completed $2 - 6 - 5 - 6 - 5 - 6 - 5 - 6 - 5 - 6 - 6$	E-log #:					
State Law requires that this report be prepared by the driller in detail and filed w 30 days of completion of drilling of the well.	rith the Department within					
Well Owner Information Well	Location					
Owner Name Johnny Turner Latitude: 30.40.513	5. Longitude: 085. 27 . 3.14.					
Mailing Address: Ramie Farm Road Method of Lat/Long (circle or	one): Conventional Survey,					
USGS quad Hand-held	GPS, Survey-grade GPS					
MOSS HOINT, MS 39562 ME 1/2 Sec 21	Twn <u>T45 RngR5W</u>					
Distance Direction	Nearest Town of <u>Hurley</u>					
Well Data						
	Other					
	Purpose of Well (circle one) Home Industrial Public Supply Irrigation Fish Culture Other:					
If flowing, method of flow regulation: Valve <u>MA</u> Other (describe)						
Static Water Level: <u>60</u> feet above or below (circle one) land surface Date measured:	- 1					
Method of Measurement (circle one) steel tape electric tape (air line) other: Hole depth: 314 FT Well depth:314 FT Well grouted to a depth of						
Type of grout (circle one): Cement (Bentonite) Mix						
Casing length: <u>299</u> feet Casing diameter: <u></u> inches Type of casing:	PVC					
Screen length: <u>15</u> feet Screen diameter: <u>2</u> inches Type of screen:	PVC					
Screen slot size: <u>• 006</u> inches Setting depth: From <u>999</u> feet to <u>314</u> feet						
Type of completion (circle all applicable): Gravel packed Underreamed Telescoped Open hole Natural Development						
Other (describe):						
Top of lap pipe or reduction in casing: <u>N/A</u> feet. If telescoped or more than one scr	een, describe on back of page					
Logs run (circle all applicable). No log run Electric Gamma Ray Density Sonic Neutron	Other:					
Name of organization running log(s): N/A I certify that the well was drilled, constructed, and completed in accordance with all applicable	e requirements of the Mississippi					
Department of Environmental Quality and/or the Mississippi Department of Health regulation						
Tack Ridgdell 0472 and	Réfler RECEVED					
Print Name of Water Well Contractor and License No.						

۲ y

Lewis Printin	g. P	as	cago	ula, l	ŴS	¢.,	ς.,		•-
Lewis Printin			ю E		Ś. 32.	S	1.	÷,	` .


R 371

If well telescopes please sketch below and show depths.

Ground Level

Desc	cription of Formations Encountered	From	To
7005		8	2
Oran	Coarsesand w/pragrave	25	56
Bluer	lay partie Sand	56	16U 182
Bille	Clay	183	191
Gray	Coderse Sand	<u>5</u> 10	쒦
Gray	COATSE SAND	ରମ	314
		l	l
I I			

If more than one screen, show location of each on sketch

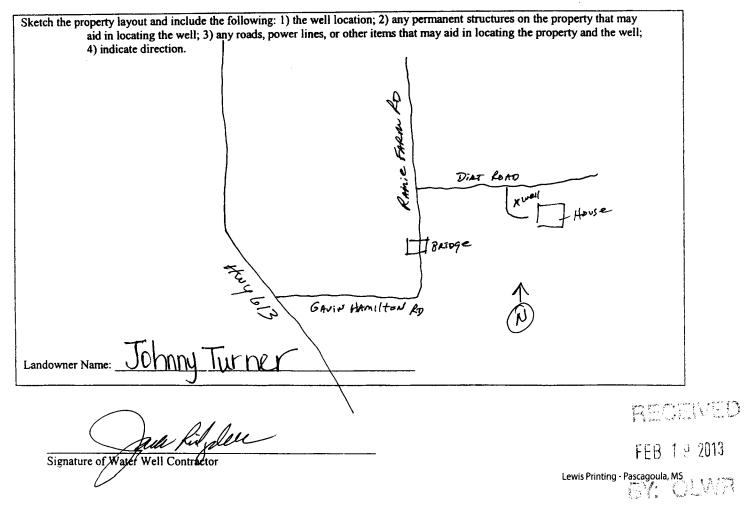

			Q371		
		ELL REPORT	r		
county: JACKSON	Part 2 Pump Installer's Completion Report		For Office Use Only:		
Permit #:		nt of Environmental Quality and Water Resources	Aquifer:		
Driller at Water Ukl SRV.	P.O. 1	Box 10631 AS 39289-0631	Well #:		
Date completed: <u>2-6-13</u>	(601) 961-5210	Elevation:		
		54-6938 (fax)			
This report should be prepared by th installation of pump.	e pump installer in deta	il and filed with the Departme	ent within 30 days of the		
Well Owner Informat	ion				
Owner Name: Johnny Turner		Latitude: <u>2040'50.38</u>	"Longitude: 088°29'38.64"		
Mailing Address: Ramie Far	mßd	Method of Lat/Long (circle on	e): Conventional Survey,		
		USGS quad, Hand	-held GPS Survey-grade GPS		
Mosspoint, M	<u>NS 39562</u>	NE 1/4 5W 1/4 Sec 2,	1_Twn 745 Rng R5W		
City State	Zip Code	Distance Direction	Nearest Town		
Telephone No. (208) 588 - 6248		2 Miles NORTH of	E Hurley		
Pump Type Circle one	· · · · · · · · · · · · · · · · · · ·		wer Type incle one		
	G . 1				
Air Lift (Jet)	Submersible		e Engine Natural Gas		
Bucket Piston	Turbine	Electric Motor Hand	Tractor PTO		
Centrifugal Rotary	Flowing Well		specify):		
Other (specify):		Horse Power Rating of Motor:			
Date Pump Installed: <u>3-11-13</u>		Setting Depth: SOFT. Dri	oppipe_feet		
Rated Pump Capacity: 7.5	Gallons Per Minute	Number of Stages:			
Pump Test Data		Method of Mea	suring Water Level		
Date Well Tested: 2-11-13			rcle one		
	Below Land Surface	Air Line Electric Meas	U 1		
Pumping Water Level (B): NA Feet B	Below Land Surface	Other (specify):			
Drawdown [(B) - (A)]: NA Feet B	Below Land Surface	For flowing well, measured she	ut in head: <u>NA</u> feet		
Test Pumping Rate: 7.5	Gallons Per Minute	Well yielded $\mathcal{Q} \mathcal{O}$ GPM with a drawdown of			
Duration of Pump Test (minimum 4 hours):	<u> 4/2</u> hours	NA feet after	NAhours of pumping		
I HEREBY CERTIFY that the above stateme JACK Ridgdell 0-47	ents are true to the best of	my knowledge	lighter ED 1 0 2010		
Print Name of Pump Installer and License No	b. (if applicable)	Signature of Pump Ins			

-

* * *

Lewis Printing - Pascagoula, MS