	State Well Report				
County Jackson	Part 1 – Driller's Log	For Office Use Only:			
	Mississippi Department of Environmental Quality				
Permit #: $b - 780$	Office of Land and Water Resources P.O. Box 2307	Well #: 2-6			
Driller: Joel Preus	Jackson, MS 39225 (601)961- 5210	L. S. Elevation: D374			
Date drilling completed: <u>1-10-08</u>	(601)961- 5228 (fax)	E-log #:			
State Law requires that this report	be prepared by the license holder responsible fo				
Department at the above address	within 30 days of completion of drilling of the w	ell or borehole. Borehole Location			
Information on Well O (Landowner if borehole is not for					
Owner Name Charles Ver	Latitude: 20 ° 70 2	10 " Longitude 20 • 27 · 030			
	Method of Lat/Long (circle	Cone): Conventional Survey.			
Mailing Address: 211 Row (*	USGS quad, Hand-h	eld GP8, Survey-grade GPS			
	DE 1/2 Second	6 TWT STORING 5W			
Huley nes	e Zip Code Distance Direction	45 Negrest Town			
	<u>412</u> Miles				
Telephone No. (228) 216 - 1613	5 EA5	T O			
	Well / Borehole Data				
	lling completed: <u>11-6-08</u> Hole depth: <u>135</u>				
Location of the source of any surface water used for drilling: <u>Aquila</u> , <u>m</u> Method of dosing and volume of Chlorine used in drilling and development: <u>2000</u> Water Aquil chilore					
1	Electric Gamma Ray Density Sonic Neutron				
	ellGeotechnical/Geological Investigation Grou	und Source Heat Pumn			
Seismic SurveyOther (describe)					
Purpose of Well (check one): Home	dustrial Public Supply Irrigation Fish Cultu	ire Other:			
	If a flowing well, method of flow regulation: Valve Other (describe)				
Static Water Level: 5 feet above or below (kircle one) land surface Date measured: 10-9-08					
Method of Measurement (circle one) steel tape electric tape air line other:					
Well depth: 135 Well grouted to a depth of 10 feet Type of grout (circle one): Neat Cement Bentonite Mix					
Casing length: 125 feet Casing diameter: 2 inches Type of casing: 3ch 40 Plaste					
Screen length: 10 feet Screen diameter: 2 inches Type of screen: Sch & Plaster					
Screen slot size: <u>10</u> inches	Setting depth: Fromfeet to	135feet			
Type of completion (circle all applicable): Gravel packed Underreamed Telescoped Open hole Natural Development					
Other (describe):					
Top of lap pipe or reduction in casing:	fect. If telescoped or more than one s	<u>creen, describe on next page</u>			
L		Form: OLWR-SWR-1A (04/08)			

4 fr

RECEIVED NOV 2 4 2008 BY: OLWR

The sketch below only required for water wells


If well telescopes, show depths on sketch.

r

न द

..

.

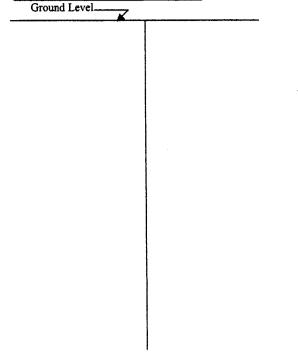

<u>Description of formations encountered must be provided for all</u> D374 wells and boreholes, unless specifically exempted by regulations

Description of Formations Encountered		To (depth)
	Ground Level	
	1	
Jellon Gant	0	40
/		
		20
freen Clay	40	90
Spen clay Cary Sand		
	80	125
- Ang nance	90	/35
~ / /	<u> </u>	
	+	
	+	
	+	1
	+	1
	1	
<u></u>	+	
	<u>+</u>	1
		1

If more than one screen, show location of each on sketch

Sketch the property layout and include the following: 1) the well location; 2) any per	ermanent structures on the property	that may
aid in locating the well; 3) any roads, power lines, or other items that n 4) a north arrow.	may and in locating the property and	Pany
		ivelog
	And my	
	1 Inorthal La	
N N	Huncely	<u> </u> £
Landowner Name: Charles Person		
	\sim	-SWR-1A (04/08)
I certify that the well/borehole was drilled, constructed, and completed in accord Mississippi Department of Environmental Quality and the Mississippi Department	ent of Health regulations, if appli-	cable, and state
laws Doll 1 0-780 11-8-08	Gel Vi	~
Print Name of Responsible Licensee and License No. Date	Signature of Licensee	RECEIVED
		NOV 242008

BY: OLWR

STATE W	ELL REPORT	
County: Pump Installer Permit #: 0 - 7 20 Driller: Joel Pie Driller: Joel Pie Date completed: 11 - 8 - 08 Copy information from block on Part 1 (601)9	Part 2 's Completion Report ent of Environmental Quality and Water Resources . Box 2309 on, MS 39225 1)961-5210 61-5228 (fax) For Office Use Only: Aquifer: Well #: D374 Elevation: D374	
This part of the report must be completed by a licensed water well report must be attached and both parts filed with the Department	at the above duaress within 50 days of rect competences	
Well Owner Information Owner Name: Charles Levous Mailing Address: 211 (Levo Bluff Rd Nucley rus 39,437 City State Zip Code Telephone No. (228) 216-1615	Well Location Latitude: <u>30-40-340</u> Longitude: <u>08-37-030</u> Method of Lat/Long (check one): Conventional Survey	
Pump Type Circle one	Power Type Circle one	
Air Lift (Jet) Submersible	Diesel Engine Gasoline Engine Natural Gas	
Bucket Piston Turbine	Hand Tractor PTO	
Centrifugal Rotary Flowing Well	Windmill Other (specify):	
Other (specify):	Horse Power Rating of Motor:	
Date Pump Installed: 10 - 8 -08	Setting Depth: 20 Jet line feet	
Rated Pump Capacity: IO Gallons Per Minute	Number of Stages:2	
Pump Test Data	Method of Measuring Water Level	
Date Well Tested:	Circle one	
Static Water Level (A):Feet Below Land Surface	Air Line Electric Measuring Line Steel Tape	
Pumping Water Level (B): <u>20</u> Feet Below Land Surface	Other (specify):	
Drawdown [(B) – (A)]:Feet Below Land Surface	For flowing well, measured shut in head:feet	
Test Pumping Rate: Gallons Per Minute	Well yielded GPM with a drawdown of	
Duration of Pump Test (minimum 4 hours):hours	2feet afterHe hours of pumping	
I HEREBY CERTIFY that the above statements are true to the bes		
Jal Vier 0-780	Del Fler	
Print Name of Pump Installer and License No. (if applicable)	Signature of Pump Installer Form: OLV	
	NOV 2 4 2	

BY: OLWR

11 M

٠

5 * ...