State W	ell Report					
County: Cacho Part 1 - I	Driller's Log	For Office Use Only:				
Mississippi Departmer	nt of Environmental Quality	Aquifer:				
0	nd Water Resources Box 2309	Well #: D 379				
	n, MS 39225					
	961- 5210	L. S. Elevation:				
(601)96	1- 5228 (fax)	E-log #:				
State Law requires that this report be prepared by the lice	ense holder responsible for i					
Department at the above address within 30 days of comp						
Information on Well Owner	Well or Bo	rehole Location				
(Landowner if borehole is not for a water well)	Latitude: 30 . 40 . 18	" Longitude: <u>88。28, 45</u> "				
Owner Name Narranole Constitution	[
Mailing Address: 743/ Baum hauto	Method of Lat/Long (circle or					
		GPS, Survey-grade GPS				
777	AF 1/5 E 1/4 Sec 28	1 1 1 1 1 1 1 1 1 1 1 1 1 1 1 1 1 1 1				
Huly ws 39562 City State Zip Code	I'SE NE					
	l Distance Direction	Nearest Town				
Telephone No. (228) - 990 0034	3_Miles <u>NE</u>	or Harry I was				
Well / Bore						
Date drilling started: 6-19-14 Date drilling completed: 6-19-	# Hole depth: <u>330</u>	Hole diameter: 2				
Location of the source of any surface water used for drilling: Method of dosing and volume of Chlorine used in drilling and devel	Gula no,	1 2 1				
Method of dosing and volume of Chlorine used in drilling and devel	opment: 2000 Water	I Igal Bleach				
Logs run (circle all applicable). No log run Electric Gamma Ray Name of organization running log(s).	Density Sonic Neutron	Other:				
Purpose of borehole (check one): Water Well Geotechnical/Geole	Purpose of borehole (check one): Water Well Geotechnical/Geological Investigation Ground Source Heat Pump					
Seismic Survey Other (describe)						
If drilling is not related to water well construction		ock				
Purpose of Well (check one): HomeIndustrial Public Supply	Irrigation Fish Culture	Other:				
If a flowing well, method of flow regulation: ValveO						
Static Water Level: feet above of below (circle one) land surface Date measured: 6-18-14						
Method of Measurement (circle one) steel tape electric tape air line other:						
Well depth: 330 Well grouted to a depth of 10 feet Type of grout (circle one): Neat Cement Bentonite Mix						
Casing length: 320 feet Casing diameter: 2 inches Type of casing: 5th 40						
Screen length: 10 feet Screen diameter: 2 inches Type of screen: 5th 40						
Screen slot size: 6 inches Setting depth: From 0 feet to 330 feet						
Type of completion (circle all applicable): Gravel packed Underreamed Telescoped Open hole Natural Development						
Other (describe):						
Top of lap pipe or reduction in casing: feet. If tele	escoped or more than one scree	n, describe on next page				
Form: OLWR-SWR-1A (04/08)						
		在大学 化				

From (depth) To (depth)
Ground Level

0

35

35

100

<u>Description of formations encountered must be provided for all wells and boreholes, unless specifically exempted by regulations</u>

Description of Formations Encountered

			green clay	100	10280
:			grey sand	280	370
			• 0		
If more than one screen	show location of each on sk	retch			
Sketch the property layout and			manent structures on the pro	nerty that may	,
aid in locating the aid and arrow	he well; 3) any roads, power	r lines, or other items that m	ay aid in locating the proper	ty and the wel	il;
					; į
					and the second
					ego - n a supplementa
					ty parage - one was parage
					American vice production of
					modern sande hir
					- Andrew -
Landowner Name:	Mariou Co	rustulion			
T	3.20 3			LWR-SWR-1	
I certify that the well/borehol Mississippi Department of En			_		
laws. Jal Pi	6-780	6-19-14	Joel 1:		
Print Name of Responsible Li	icensee and License No.	Date	Signature of Licensee		

The sketch below only required for water wells


If well telescopes, show depths on sketch.
Ground Level.



Map of: Hurley, MS

Notes



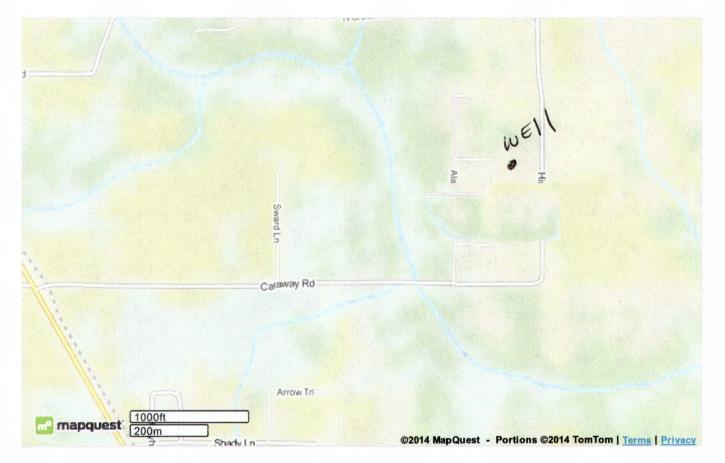

©2014 MapQuest, Inc. Use of directions and maps is subject to the MapQuest Terms of Use. We make no guarantee of the accuracy of their content, road conditions or route usability. You assume all risk of use. View Terms of Use



County: Jackson Permit #: 0 - 780 Driller: Joel (14-14) Copy information from block on Part 1 This part of the report must be completed	STATE WELL REPORT Part 2 Pump Installer's Completion Report Mississippi Department of Environmental Quality Office of Land and Water Resources P.O. Box 2309 Jackson, MS 39225 (601)961-5210 (601)961-5228 (fax)		For Office Use Only: Aquifer: Well #: D 3 79 Elevation:		
This part of the report must be completed by a licensed water well contractor or a licensed pump installer. A copy of Part 1 of the report must be attached and both parts filed with the Department at the above address within 30 days of well completion.					
Well Owner Information Owner Name: Name: Carrier Mailing Address: 7431 Daw f City State Telephone No. (278, 990 - 02)	Jaullo Rd 39452 Zip Code		GPS V Survey-grade GPS		
Pump Type Circle one		1	ver Type		
Air Lift Jet	Submersible	Diesel Engine Gasoline	e Engine Natural Gas		
Bucket Piston	Turbine	Electric Motor Hand	Tractor PTO		
Centrifugal Rotary	Flowing Well	Windmill Other (s	specify):		
Other (specify): Horse Power Rating of Motor:					
Date Well Tested: Pump Test Data O-19-19 Static Water Level (A): Feet	Below Land Surface	Cir Air Line Electric Meas			
Pumping Water Level (B): 40 Feet I	Below Land Surface	Other (specify):			
. 0	Below Land Surface	For flowing well, measured shu			
Test Pumping Rate:	Gallons Per Minute hours	Well yielded <u>fO</u> feet after	GPM with a drawdown of Hours of pumping		
This is for (circle one): New Well Replacement of Existing Pump Repair of Existing Pump I HEREBY CERTARY that the above statements are true to the best of my knowledge.					
Print Name of Pump Installer and License No. (if applicable) Signature of Pump Installer Form: OLWR-SWR-1C (07-09)					