STATE WEI	For Office Lise Only
County: Jackson Par	
Permit #:	& Emironmental Quality
Driller: CDAG+ Marter Uel SUC Office of Land and	Water Resources
P.O. B	e-Log #:
	39225-2309
	0535 (fax)
State Law requires that this report be prepared by the licens Department at the above address within 30 days of completi	e holder responsible for the work and filed with the on of drilling of the well or borehole.
Well Owner Information	Well or Borehole Location
(Landowner if borehole is not for a water well)	ude: <u>20 40'32,58'(</u> 00) ude: 088'31' 10.26''
Frankleihorn	
Lavin Hamilton KD Mey	od of Lat/Long (check one): Conventional Survey,
USG	5 quad, Hand-held GPS, Survey-grade GPS
Missibiat M-5 39562	16 1/4 NE 14, Sec 30 T 45 R 500
City State Zip Code	14 Miles NW of Herelay
	tance) (Direction) (Nearest Town)
Well / Boreh Date drilling started: 1-12-112 Date drilling completed: 1-1	ble Data 2-16 Hole depth: 170 FTHole diameter: 2"
the state of any surface water used for drilling	N/A
Method of dosing and volume of Chlorine used in drilling and de	velopment: 1gal Der 1000 Drilling 2gal in well
Logs run (circle all applicable): No log run Electric Gamma Ra	y Density Sonic Neutron Other:
Name of organization running log(s):	
Purpose of borehole (circle one): Water Well Geotechnical/C	
Seismic Survey Other (desc	
If drilling is not related to water well constr	uction, skip the remainder of this block
Purpose of Well (circle all applicable: Home Industrial Pu	blic Supply Irrigation Fish Culture FEB 0.5 20
Other (describe):	
If a flowing well, method of flow regulation: Valve	
Static Water Level:	d surface Date measured: <u>1-6-10</u>
Method of measurement (circle one): Steel tape Electric tape	
Well depth: 10 FT Well grouted to a depth of: 10 feet	
Casing length: 100 feet Casing diameter:	inches Type of casing: $\rho V C$
Screen length:feet Screen diameter:	inches Type of screen: <u>PUC</u>
Screen slot size:OOCinches Setting depth: Fro	
Type of completion (circle all applicable): Gravel packed	Inderreamed Open hole Natural Development
Other (describe):	
Top of lap pipe or reduction in casing: $\frac{N/A}{feet}$	describe on part page
If telescoped or more than one	screen, describe on next page Form: OLWR-SWR-1A (4

ŝ

à.


County: JAIKEON	
Permit #:	

For Office U	Jse Only:
well #: <u>039</u>	10
	(

The sketch below only required for water wells

Description of formations encountered must be provided for all wells and boreholes, unless specifically exempted by regulations

If well telescopes, show depths on sketch.

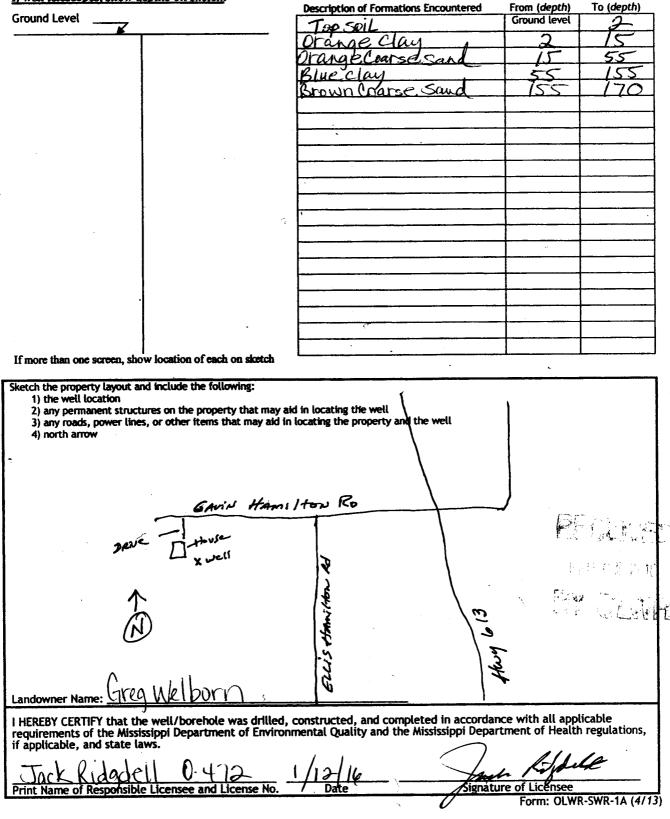

County: DACKATT	Part 2	For Office Use Only:
Pump Installe	er's Completion Report	Well #: 0.39 4
	ment of Environmental Quality nd and Water Resources	Well #: (D. 0 - 1 - 4
Date completed: 1-le-lb P	P.O. Box 2309	Aquifer:
	on, MS 39225-2309 601)961-5210	Auguner,
(601) 360-0535 (fax)	···· <u></u> ·· ···· ······························
This part of the report must be completed by a licensed water of the report must be attached and both parts filed with the l	r well contractor or a licensed pun	p installer. A copy of Part 1
Well Owner Information	· Well Lo	ocation_
owner Name Greg Welborn RD.	Latitude: 30° 40'32.58'Lon	ritude: 088°31'10.26
Mailing Address: Gavin Hamilton	Method of Lat/Long (check one)	
	USGS quad, Hand-held GP	
Moss Roint, M5 39542	NW 4 NE 4, Sec.	••
City State Zip Code	1	•
Telephone No. (228 990 - 72-90	(Distance) (Direction) of	Hurley (Negrest Town)
Pump Tv	pe (circle one)	
Submersible Turbine Air Lift Centrifugal Flowing Well		cribe):
	Rated Pump Capacity:	
Is This Pump (circle one); (New) Repaired Replaceme		
	nc rpe (circle one)	<u></u>
Electric Diesel Gasoline Natural Gas Tractor PTO Wir	• • •	
	th: <u>60FTDP_feet</u> Number	0
· M i/	for Non Flowing Well	
Date Well Tested: 1-1-16		
Static Water Level (A): 35 Feet Below Land Surface	Pumping Water Level (B): _/	Feet Below Land Surfa
	Pumping Water Level (B): _/	Feet Below Land Surfa
Static Water Level (A): <u>35</u> Feet Below Land Surface Drawdown [(B) - (A)]: <u>N</u> Feet Below Land Sur Method of measurement (<i>circle one</i>): Steel tape Electric t	Pumping Water Level (B): face Test Pumping Rate: ape (Air line & Other (<i>describe</i>): _	A Feet Below Land Surfa
Static Water Level (A): <u>35</u> Feet Below Land Surface Drawdown [(B) - (A)]: <u>N(A</u> Feet Below Land Sur Method of measurement (<i>circle one</i>): Steel tape Electric t Pump Test Da	e Pumping Water Level (B): _/ face Test Pumping Rate:	A Feet Below Land Surfa
Static Water Level (A): <u>35</u> Feet Below Land Surface Drawdown [(B) - (A)]: <u>N</u> Feet Below Land Sur Method of measurement (<i>circle one</i>): Steel tape Electric t	Pumping Water Level (B): face Test Pumping Rate: ape (Air line & Other (<i>describe</i>): _	A Feet Below Land Surfa
Static Water Level (A): <u>35</u> Feet Below Land Surface Drawdown [(B) - (A)]: <u>N(A</u> Feet Below Land Sur Method of measurement (<i>circle one</i>): Steel tape Electric t Pump Test Da	e Pumping Water Level (B): face Test Pumping Rate: ape (Air line Cother (<i>describe</i>): ta for Flowing Well	A Feet Below Land Surfa
Static Water Level (A): <u>35</u> Feet Below Land Surface Drawdown [(B) - (A)]: <u>N(A</u> Feet Below Land Sur Method of measurement (<i>circle one</i>): Steel tape Electric t Pump Test Da Measured shut in head:feet. / Well yieldedGPM with a drawdown of	e Pumping Water Level (B): face Test Pumping Rate: rape (Air Line Other (<i>describe</i>): nta for Plowing Well V//A feet after Installation	A Feet Below Land Surfa 9 Gallons Per Minu hours of pumping
Static Water Level (A): <u>35</u> Feet Below Land Surface Drawdown [(B) - (A)]: <u>N(A</u> Feet Below Land Sur Method of measurement (<i>circle one</i>): Steel tape Electric t Pump Test Da Measured shut in head:feet. / Well yielded GPM with a drawdown of Meter	e Pumping Water Level (B): face Test Pumping Rate: ape Air Line Other (<i>describe</i>): ita for Plowing Well V/A feet after Installation A Meter Serial Number:	A Feet Below Land Surfa Gallons Per Minu hours of pumping
Static Water Level (A): <u>35</u> Feet Below Land Surface Drawdown [(B) - (A)]: <u>N(A</u> Feet Below Land Sur Method of measurement (<i>circle one</i>): Steel tape Electric t Pump Test Da Measured shut in head:feet. / Well yielded GPM with a drawdown of Meter	e Pumping Water Level (B): face Test Pumping Rate: ape Air Line Other (<i>describe</i>): ita for Plowing Well V/A feet after Installation A Meter Serial Number:	A Feet Below Land Surfa Gallons Per Minu hours of pumping
Static Water Level (A): <u>35</u> Feet Below Land Surface Drawdown [(B) - (A)]: <u>N(A</u> Feet Below Land Sur Method of measurement (<i>circle one</i>): Steel tape Electric t Pump Test Da Measured shut in head:feet. / Well yieldedGPM with a drawdown of Meter Manufacturer: Meter Model Number/Name:	e Pumping Water Level (B): face Test Pumping Rate: ape (Air line Other (describe): ita for Prowing Well V/A feet after Installation A Meter Serial Number: Type of Meter:	A Feet Below Land Surfa Gallons Per Minu hours of pumping
Static Water Level (A): <u>35</u> Feet Below Land Surface Drawdown [(B) - (A)]: <u>N(A</u> Feet Below Land Sur Method of measurement (<i>circle one</i>): Steel tape Electric t Pump Test Da Measured shut in head:feet. / Well yielded GPM with a drawdown of Meter Manufacturer: Meter Model Number/Name: Totalizer Register Unit and Multiplier Factor (AF x .001, ga	Pumping Water Level (B): face Test Pumping Rate: ape (Air Line Other (describe): ita for Flowing Well V/A feet after Installation A Meter Serial Number: A Type of Meter: at x 1000, etc):	A Feet Below Land Surfa Gallons Per Minu hours of pumping
Static Water Level (A): 35 Feet Below Land Surface Drawdown [(B) - (A)]: N (AFeet Below Land Sur Method of measurement (circle one): Steel tape Electric t Pump Test Da Measured shut in head: feet. / Well yielded GPM with a drawdown of Meter Manufacturer:	Pumping Water Level (B):	A Feet Below Land Surfa Gallons Per Minu hours of pumping
Static Water Level (A): <u>35</u> Feet Below Land Surface Drawdown [(B) - (A)]: <u>NA</u> Feet Below Land Sur Method of measurement (circle one): Steel tape Electric t Pump Test Da Measured shut in head:feet. / Well yielded GPM with a drawdown of Meter Manufacturer: Meter Model Number/Name: Totalizer Register Unit and Multiplier Factor (AF x .001, ga Installation Date: Meter installed by: Is This Meter (circle one): New Repaired Replacem	Pumping Water Level (B):	A Feet Below Land Surfa Gallons Per Minu hours of pumping
Static Water Level (A): 35 Feet Below Land Surface Drawdown [(B) - (A)]: N(A Feet Below Land Sur Method of measurement (circle one): Steel tape Electric t Pump Test Da Measured shut in head: feet. / Well yielded feet. / Well yielded feet. / Meter Manufacturer: / Meter Model Number/Name: /// Totalizer Register Unit and Multiplier Factor (AF x .001, ga Installation Date: Meter installed by: Is This Meter (circle one): New Repaired Replacem Important: By submitting the above information you are compared.	Pumping Water Level (B):	HA Feet Below Land Surfa Gallons Per Minu hours of pumping Participation Hed to manufacturer standard
Static Water Level (A): <u>35</u> Feet Below Land Surface Drawdown [(B) - (A)]: <u>N</u> (A Feet Below Land Sur Method of measurement (circle one): Steel tape Electric t Pump Test Da Measured shut in head:feet. / Well yieldedfeet. / Well yieldedfeet. / Well yieldedfeet. / Meter Manufacturer: Meter Model Number/Name: Totalizer Register Unit and Multiplier Factor (AF x .001, ga Installation Date: Meter installed by: Is This Meter (circle one): New Repaired Replacem Important: By submitting the above information you are of For agricultural wells, a list of agri	Pumping Water Level (B): face Test Pumping Rate: face Test Pumping Rate: face Test Pumping Rate: face Test Pumping Rate: for Flowing Well /feet after feet after Installation /feet Serial Number: AType of Meter: it x 1000, etc): nent rent rentifying that this meter was installation /	Hed to manufacturer standard
Static Water Level (A): 35 Feet Below Land Surface Drawdown [(B) - (A)]: N(A Feet Below Land Sur Method of measurement (circle one): Steel tape Electric t Pump Test Da Measured shut in head: feet. / Well yielded feet. / Well yielded feet. / Meter Manufacturer: / Meter Model Number/Name: /// Totalizer Register Unit and Multiplier Factor (AF x .001, ga Installation Date: Meter installed by: Is This Meter (circle one): New Repaired Replacem Important: By submitting the above information you are compared.	Pumping Water Level (B): face Test Pumping Rate: face Test Pumping Rate: face Test Pumping Rate: face Test Pumping Rate: for Flowing Well /feet after feet after Installation /feet Serial Number: AType of Meter: it x 1000, etc): nent rent rentifying that this meter was installation /	HA Feet Below Land Surfa Gallons Per Minu hours of pumping Hed to manufacturer standards
Static Water Level (A): <u>35</u> Feet Below Land Surface Drawdown [(B) - (A)]: <u>N(A</u> Feet Below Land Sur Method of measurement (circle one): Steel tape Electric t Pump Test Da Measured shut in head:feet. // Well yieldedGPM with a drawdown of Meter Manufacturer: Meter Model Number/Name: Totalizer Register Unit and Multiplier Factor (AF x .001, ga Installation Date: Meter installed by: Is This Meter (circle one): New Repaired Replacem Important: By submitting the above information you are of For agricultural wells, a list of agricultu	Pumping Water Level (B):	HA Feet Below Land Surfa Gallons Per Minu hours of pumping