
State W	ell Report -	T OF N O		
	Priller's Log	For Office Use Only:		
Mississippi Departmer	t of Environmental Quality Aquality Aquality	uifer: <u>D 409</u>		
P.O.	Box 2309 We	11#:		
	, MS 39225 961- 5210	S. Elevation:		
	L 5228 (fav)	og#:		
State Law requires that this report be prepared by the lic Department at the above address within 30 days of comp				
Information on Well Owner	Well or Boreho			
(Landowner if borehole is not for a water well)	Latitude: 30 • 39 • 71 " Lo	09.70.77		
Owner Name / Costulia	Latitude: 70 ° 77 ' Z 1 " Lo	ongitude: Od "CO" CO"		
Mailing Address: 113 Colons Consta Rd	Method of Lat/Long (circle one): (ľ		
	USGS quad, Hand-held GP3			
Hules ND 39562	1 Sec 34 T	$wn 45^{\circ}Rng5\omega$		
City State Zip Code	Distance Direction of Miles	Nearest Town		
Telephone No. (228) 990 - 4800	Milesor	7/10047, 100		
Well / Borehole Data Date drilling started: 10-17-16 Date drilling completed: 10-17-16 Hole depth: 45 Hole diameter: 2				
		<u> </u>		
Location of the source of any surface water used for drilling: Method of dosing and volume of Chlorine used in drilling and development: Logs run (circle all applicable): No log run Electric Gamma Ray Density Sonic Neutron Other:				
Logs run (circle all applicable): No log run Electric Gamma Ray Name of organization running log(s):	Density Sonic Neutron Other			
Purpose of borehole (check one): Water Well Geotechnical/Geological Investigation Ground Source Heat Pump				
Purpose of borehole (check one): Water Well Geotechnical/Geological Investigation Ground Source Heat Pump Seismic Survey Other (describe) If drilling is not related to water well construction, skip the remainder of this block				
Purpose of Well (check one): Home Industrial Public Supply Irrigation Fish Culture Other:				
If a flowing well, method of flow regulation: Valve Other (describe)				
Static Water Level: feet above or lelow (circle one) !	and surface Date measured:	6-17-66		
Method of Measurement (circle one) steel tape electric tape	air line other:			
Well depth: 45 Well grouted to a depth of 10 feet Type of grout (circle one): Neat Cement Bentonite Mix				
Casing length: 40 feet Casing diameter: 2	_inches Type of casing:	lastu		
Screen length: 5 feet Screen diameter: 2	_inches Type of screen:	ash		
Screen slot size: 10 inches Setting depth: From 5 feet to 45 feet				
Type of completion (circle all applicable): Gravel packed Under	reamed Telescoped Open hole	Natural Development		
Other (describe):		<u> </u>		

Top of lap pipe or reduction in casing: _

Form: OLWR-SWR-1A (04/08)

feet. If telescoped or more than one screen, describe on next page

RECEIVED 0CT 31 2016 BY OLWR

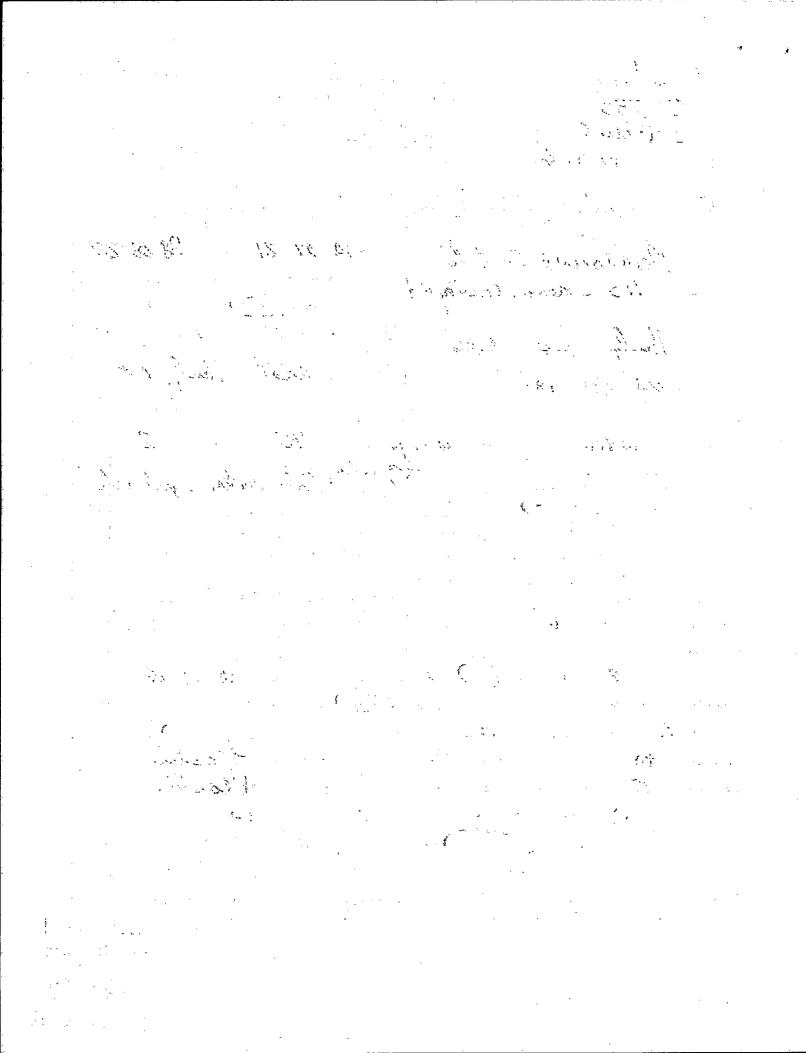

STATE WELL REPORT Part 2 For Office Use Only: **Pump Installer's Completion Report** Mississippi Department of Environmental Quality Aquifer: Office of Land and Water Resources P.O. Box 2309 Well#: DA09 Jackson, MS 39225 Date completed: (601)961-5210 Elevation: (601)961-5228 (fax) Copy information from block on Part 1 This part of the report must be completed by a licensed water well contractor or a licensed pump installer. A copy of Part 1 of the report must be attached and both parts filed with the Department at the above address within 30 days of well completion. **Well Owner Information** Well Location Latitude: 70-39-21 Longitude: 88-28-27 Method of Lat/Long (check one): Conventional Survey___ USGS quad , Hand-held GPS Survey-grade GPS Distance Direction Nearest Town Telephone No. (2 Pump Type Power Type Circle one Circle one Air Lift Jet Submersible Diesel Engine Gasoline Engine Natural Gas Tractor PTO Bucket Piston Turbine Electric Motor Hand Centrifugal Rotary Flowing Well Windmill Other (specify): Horse Power Rating of Motor: Other (specify): 10-17-16 Date Pump Installed: Setting Depth: Gallons Per Minute Rated Pump Capacity: Number of Stages: Method of Measuring Water Level Pump Test Data Circle one 10-17-16 Date Well Tested: Air Line Electric Measuring Line Steel Tape Static Water Level (A): _ Feet Below Land Surface Other (specify): Pumping Water Level (B): 15 Feet Below Land Surface

<u></u>		
I HEREBY CERTIFY that the above statements are true to the best of	my knowledge.	
Soel 1040 0-780	sel View	DECENTER
Print Name of Pump Installer and License No. (if applicable)	Signature of Pump Installer	REUEIV
	Enemy Ol	MD SMD 48 (04/08)

For flowing well, measured shut in head: ___

feet after

Well vielded ()

Feet Below Land Surface

Gallons Per Minute

Drawdown [(B) - (A)]:

Test Pumping Rate:

10

Duration of Pump Test (minimum 4 hours):

GPM with a drawdown of

hours of pumping

Description of formations encountered must be provided for all wells and boreholes, unless specifically exempted by regulations

Ground Level	Description of Formations Encountered		To (depth)
		Gröund Level	
	Same		45
If more than one screen, show location of each on sket	-		
and the state of t	ColEMAN Central		
		Roul	ad
andowner Name: Na Mauon Consti	Hur () (M OLWR-SWR-1A	(04/08)
ertify that the well/borehole was drilled, constructed, ar			• ,
ssissippi Department of Environmental Quality and the	e Mississippi Department of Health regulation	<i>1</i>	
Doel Pierre 0-190 1	15/7-86 Joel VI	ecco	CEIV
nt Name of Responsible Licensee and License No.	Date /6 Signature of Licen	isee 0	CT 312
			YOL

The sketch below only required for water wells

If well telescopes, show depths on sketch.

Ground Level.