

STATE WELL REPORT

Part 1

Driller's Log

Mississippi Department of Environmental Quality
Office of Land and Water Resources
P.O. Box 2309
Jackson, MS 39225-2309
(601)961-5210
(601)360-0535 (fax)

For Office Use Only:

Well #: D415
Aquifer: _____
E-Log #: _____

County: Jackson
Permit #: 0-780
Driller: J. P. Dient
Date drilling completed: 4-15-17

State Law requires that this report be prepared by the license holder responsible for the work and filed with the Department at the above address within 30 days of completion of drilling of the well or borehole.

| Well Owner Information <small>(Landowner if borehole is not for a water well)</small> | Well or Borehole Location |
|--|---|
| Owner Name: <u>Narramore Construction</u> | Latitude: <u>30-39-40</u> Longitude: <u>88-30-26</u> |
| Mailing Address: <u>North View Rd</u> | <u>42</u> |
| City: <u>Humboldt</u> State: <u>MS</u> Zip Code: <u>39562</u> | Method of Lat/Long (check one): Conventional Survey _____ |
| Telephone No.: <u>228 990-2911</u> | USGS quad _____, Hand-held GPS <input checked="" type="checkbox"/> , Survey-grade GPS _____ |
| | <u>SENE 1/4 NE NW 32 30 T 45 R 5 W</u> |
| | <u>1</u> Miles <u>West</u> of <u>Humboldt, MS</u> |
| | (Distance) (Direction) (Nearest Town) |

| Well / Borehole Data |
|--|
| Date drilling started: <u>4-14-16</u> Date drilling completed: <u>4-14-17</u> Hole depth: <u>55</u> Hole diameter: <u>2</u> |
| Location of the source of any surface water used for drilling: <u>Aquifer, MS</u> |
| Method of dosing and volume of Chlorine used in drilling and development: <u>2000 water 5 gal bleach</u> |
| Logs run (circle all applicable): <input checked="" type="checkbox"/> No log run <input type="checkbox"/> Electric <input type="checkbox"/> Gamma Ray <input type="checkbox"/> Density <input type="checkbox"/> Sonic <input type="checkbox"/> Neutron <input type="checkbox"/> Other: _____ |
| Name of organization running log(s): _____ |
| Purpose of borehole (circle one): <input checked="" type="checkbox"/> Water Well <input type="checkbox"/> Geotechnical/Geological Investigation <input type="checkbox"/> Ground Source Heat Pump |
| Seismic Survey <input type="checkbox"/> Other (describe) _____ |

If drilling is not related to water well construction, skip the remainder of this block

| |
|--|
| Purpose of Well (circle all applicable): <input checked="" type="checkbox"/> Home <input type="checkbox"/> Industrial <input type="checkbox"/> Public Supply <input type="checkbox"/> Irrigation <input type="checkbox"/> Fish Culture |
| Other (describe): _____ |
| If a flowing well, method of flow regulation: Valve _____ Other (describe) _____ |
| Static Water Level: <u>3</u> feet [above or <input checked="" type="checkbox"/> below] land surface Date measured: <u>4-15-17</u> <small>(circle one)</small> |
| Method of measurement (circle one): Steel tape <input type="checkbox"/> Electric tape <input type="checkbox"/> <input checked="" type="checkbox"/> Air line <input type="checkbox"/> Other (describe): _____ |
| Well depth: <u>55</u> Well grouted to a depth of: <u>10</u> feet Type of grout (circle one): Neat Cement <input type="checkbox"/> <input checked="" type="checkbox"/> Bentonite <input type="checkbox"/> Mix |
| Casing length: <u>50</u> feet Casing diameter: <u>2</u> inches Type of casing: <u>Plaster</u> |
| Screen length: <u>5</u> feet Screen diameter: <u>2</u> inches Type of screen: <u>Plastic</u> |
| Screen slot size: <u>10</u> inches Setting depth: From <u>0</u> feet to <u>55</u> feet |
| Type of completion (circle all applicable): <input checked="" type="checkbox"/> Gravel packed <input type="checkbox"/> Underreamed <input type="checkbox"/> Open hole <input type="checkbox"/> Natural Development |
| Other (describe): _____ |
| Top of lap pipe or reduction in casing: _____ feet |

If telescoped or more than one screen, describe on next page

RECEIVED
APR 25 2017
BY OLW

STATE WELL REPORT

Part 2

Pump Installer's Completion Report
 Mississippi Department of Environmental Quality
 Office of Land and Water Resources
 P.O. Box 2309
 Jackson, MS 39225-2309
 (601)961-5210
 (601) 360-0535 (fax)

For Office Use Only:

Well #: D415
 Aquifer: _____

County: Jackson
 Permit #: 07780
 Driller: J. P. ...
 Date completed: 4-15-17

Copy information from block on Part 1

This part of the report must be completed by a licensed water well contractor or a licensed pump installer. A copy of Part 1 of the report must be attached and both parts filed with the Department at the above address within 30 days of well completion.

| Well Owner Information | Well Location |
|---|---|
| Owner Name: <u>Nannan Contract</u> | Latitude: <u>30-39-48</u> Longitude: <u>88-30-26</u> |
| Mailing Address: <u>North View Rd</u> | Method of Lat/Long (check one): Conventional Survey _____ <small>AZ</small> |
| City: <u>Hubb</u> State: <u>MS</u> Zip Code: <u>39562</u> | USGS quad _____, Hand-held GPS <input checked="" type="checkbox"/> Survey-grade GPS _____ |
| Telephone No. <u>(228)-990-2911</u> | <u>SENE</u> 1/4 <u>NE</u> 1/4, Sec <u>30</u> T <u>45</u> R <u>5W</u> |
| | <u>1</u> Miles <u>west</u> of <u>Hubb, MS</u> <small>(Distance) (Direction) (Nearest Town)</small> |

Pump Type (circle one)

Submersible Turbine Air Lift Centrifugal Flowing Well Jet Piston Rotary Other (describe): _____

Date Pump Installed: 4-15-17 Rated Pump Capacity: 10 Gallons Per Minute

Is This Pump (circle one): New Repaired Replacement

Power Type (circle one)

Electric Diesel Gasoline Natural Gas Tractor PTO Windmill Other (describe): _____

Horse Power Rating of Motor: _____ Setting Depth: _____ feet Number of Stages: _____

Pump Test Data for Non Flowing Well

Date Well Tested: 4-15-17 Duration of Pump Test (minimum 4 hours): 48 hours

Static Water Level (A): 3 Feet Below Land Surface Pumping Water Level (B): 20 Feet Below Land Surface

Drawdown [(B) - (A)]: 2 Feet Below Land Surface Test Pumping Rate: 10 Gallons Per Minute

Method of measurement (circle one): Steel tape Electric tape Air line Other (describe): _____

Pump Test Data for Flowing Well

Measured shut in head: _____ feet.

Well yielded _____ GPM with a drawdown of _____ feet after _____ hours of pumping

Meter Installation

Meter Manufacturer: _____ Meter Serial Number: _____

Meter Model Number/Name: _____ Type of Meter: _____

Totalizer Register Unit and Multiplier Factor (AF x .001, gal x 1000, etc): _____

Installation Date: _____ Meter installed by: _____

Is This Meter (circle one): New Repaired Replacement

Important: By submitting the above information you are certifying that this meter was installed to manufacturer standards. For agricultural wells, a list of approved meters is on the MDEQ website.

I HEREBY CERTIFY that the above statements are true to the best of my knowledge.

APR 25 2017

BY OLWR


Print Name of Pump Installer and License No. (if applicable) _____ Date _____ Signature of Pump Installer _____

County: Jackson
 Permit #: _____

For Office Use Only:
 Well #: D415

The sketch below only required for water wells


If well telescopes, show depths on sketch.

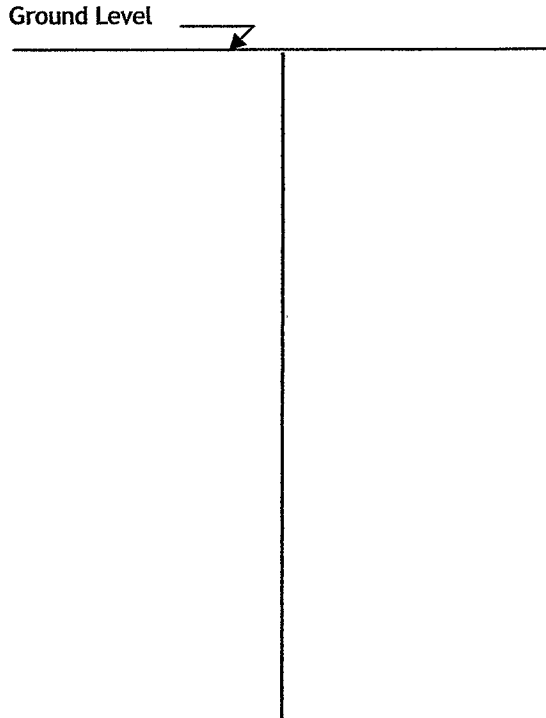

Description of formations encountered must be provided for all wells and boreholes, unless specifically exempted by regulations

| Description of Formations Encountered | From (depth) | To (depth) |
|---------------------------------------|--------------|------------|
| | Ground level | |
| <u>sand</u> | <u>0</u> | <u>55</u> |
| | | |
| | | |
If more than one screen, show location of each on sketch

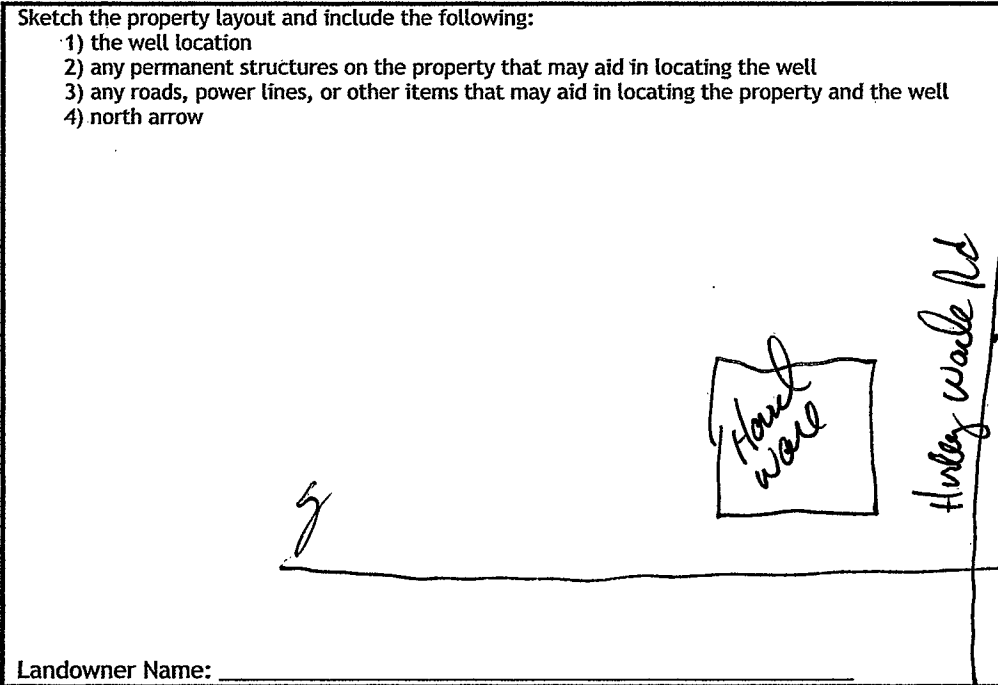

north flow
RECEIVED
 APR 25 2017
 BY OLWR
 Hug 6/3
 N

Landowner Name: _____

I HEREBY CERTIFY that the well/borehole was drilled, constructed, and completed in accordance with all applicable requirements of the Mississippi Department of Environmental Quality and the Mississippi Department of Health regulations, if applicable, and state laws.

Joel Paine 0-780 4-15-17 Joel Paine

Print Name of Responsible Licensee and License No. Date Signature of Licensee