

STATE WELL REPORT

Part 1

Driller's Log

Mississippi Department of Environmental Quality
Office of Land and Water Resources
P.O. Box 2309
Jackson, MS 39225-2309
(601)961-5555
(601)961-5228 (fax)

For Office Use Only:

Well #: D471

Aquifer: _____

E-Log #: _____

elev 108

RECEIVED

02-01-2022

BY OLWR

County: Jackson
Permit #: _____
Driller: Michael Fryfogle
Date drilling completed: 11/06/2021

State Law requires that this report be prepared by the license holder responsible for the work and filed with the Department at the above address within 30 days of completion of drilling of the well or borehole.

Well Owner Information <i>(Landowner if borehole is not for a water well)</i>	Well or Borehole Location
Owner Name: <u>Michael Chavez</u>	Latitude: <u>30.6780880</u> Longitude: <u>-88.4866790</u>
Mailing Address: <u>8100 Pecan Ridge</u>	Method of Lat/Long (check one): Conventional Survey _____, USGS quad _____, Hand-held GPS <input checked="" type="checkbox"/> , Survey-grade GPS _____
<u>Moss Point</u> <u>MS</u> <u>39562</u>	<u>SW</u> ¼ <u>SE</u> ¼, Sec <u>21</u> T <u>4S</u> R <u>5W</u>
City State Zip Code	<u>1.72</u> Miles <u>NE</u> of <u>Hurley</u>
Telephone No. (____) _____	(Distance) (Direction) (Nearest Town)

Well / Borehole Data

Date drilling started: 11/06/2021 Date drilling completed: 11/06/2021 Hole depth: 400 Hole diameter: 4 1/4

Location of the source of any surface water used for drilling: _____

Method of dosing and volume of Chlorine used in drilling and development: _____

Logs run (check all applicable): No log run Electric Gamma Ray Density Sonic Neutron Other: _____

Name of organization running log(s): _____

Purpose of borehole (check one): Water Well Geotechnical/Geological Investigation Ground Source Heat Pump
Seismic Survey Other (describe) _____

If drilling is not related to water well construction, skip the remainder of this block

Purpose of Well (check all applicable): Home Industrial Public Supply Irrigation Fish Culture

Other (describe): _____

If a flowing well, method of flow regulation: Valve _____ Other (describe) _____

Static Water Level: 40 feet [above or below] land surface Date measured: 11/06/2021
(check one)

Method of measurement (check one): Steel tape Electric tape Air line Other (describe): _____

Well depth: 400 Well grouted to a depth of: 10 feet Type of grout (check one): Neat Cement Bentonite Mix

Casing length: 385 feet Casing diameter: 2 inches Type of casing: Sch40

Screen length: 15 feet Screen diameter: 2 inches Type of screen: Wrap

Screen slot size: .06 inches Setting depth: From 385 feet to 400 feet

Type of completion (check all applicable): Gravel packed Underreamed Open hole Natural Development

Other (describe): _____

Top of lap pipe or reduction in casing: _____ feet


If telescoped or more than one screen, describe on next page



County: Jackson
 Permit #: _____

For Office Use Only:
 Well #: D471

The sketch below only required for water wells
If well telescopes, show depths on sketch.

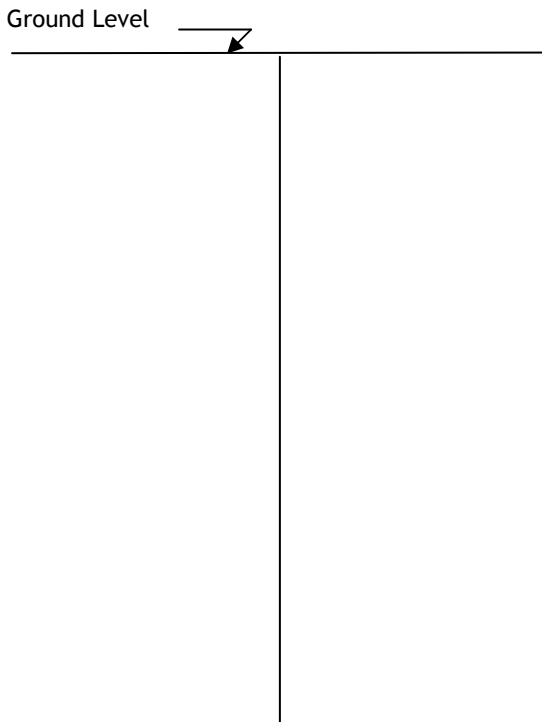

Description of formations encountered must be provided for all wells and boreholes, unless specifically exempted by regulations

Description of Formations Encountered	From (depth)	To (depth)
Mix	Ground level	18
Sand	18	22
Clay bad sticky	22	115
fine sand	115	123
Clay	123	205
Silt	205	225
Clay	225	285
Silt	285	305
Clay	305	345
Silt	345	360
Clay mix silt	360	380
Sand	380	400

If more than one screen, show location of each on sketch

- Sketch the property layout and include the following:
- 1) the well location
 - 2) any permanent structures on the property that may aid in locating the well
 - 3) any roads, power lines, or other items that may aid in locating the property and the well
 - 4) north arrow



Landowner Name: Michael Chavez

I HEREBY CERTIFY that the well/borehole was drilled, constructed, and completed in accordance with all applicable requirements of the Mississippi Department of Environmental Quality and the Mississippi Department of Health regulations, if applicable, and state laws.

Michael Fryfogle 0408 01/28/2022
 Print Name of Responsible Licensee and License No. Date



Michael Fryfogle
 Signature of Licensee