

Jackson  
D 2000  
11-21-75

MISSISSIPPI  
BOARD OF WATER COMMISSIONERS  
416 North State Street  
Jackson, Mississippi 39201

WATER WELL DRILLERS LOG

Nov. 21/1975 19 *G. J. ...* firm name *Jackson* county well located

LANDOWNER: *Paul ...*

description of formations encountered

from to

*Passapatania ...*

*tan on silt* 0' *9'*

(mailing address)

WELL LOCATION:

sec *14* T *4* N R *5* *SE* *W*  
*2 1/2* miles *N-F* of *Husley*  
(distance) (direction) (nearest town)

*white sand soil* 4' *22'*

WELL PURPOSE: *Home*  
(home, irrigation, municipal, industrial)

WELL COMPLETION DATA:

- (1) diameter (inches) 2"
- (2) total depth (feet) 130'
- (3) static water level (feet) 0 below top of ground.
- (4) casing PVC 130'  
(material) (depth)

*blue clay* 32' *38'*

*white silt* 38' *75'*

*blue clay* 75' *90'*

*blue clay* 90' *120'*

*undrained grey sand* 120' *135'*

(size) If telescope see back.

(5) screen 5" 130'  
(length) (depth to top)

2" PVC  
(size) (material)

(6) pump 1/2 130'  
(HP) (yield gpm)

etc  
(type power)

(7) electric log no  
(yes or no)

(organization running log)

(8) how well bottom plugged Ball


DRILLERS REMARKS:

JAN 8 1976

MISS. Bd of WATER COMMISSIONERS

If well telescopes please sketch and show depths.

GROUND LEVEL

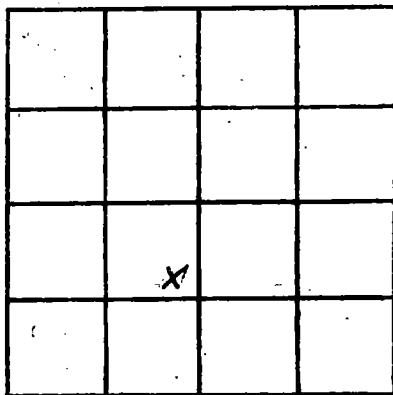

SECTION 14

Please indicate well location X.

ADDITIONAL INFORMATION

If more than one screen, show locations of each on sketch.