

JACKSON

MISSISSIPPI BOARD OF WATER COMMISSIONERS

D 2000

416 North State Street

2-20-76

Jackson, Mississippi 39201

13R

WATER WELL DRILLERS LOG

30-20

1976 High Hills

3

date well completed

firm name

county well located

LANDOWNER: Henry J. ...

description of formations encountered

from to

Red clay

red clay

0' 18'

(mailing address)

WELL LOCATION:

sec. 7 T 4 N R 4 E  
S W  
miles of ...  
(distance) (direction) (nearest town)

...

18' 26'

...

26' 45'

...

45' 60'

WELL PURPOSE:

(home, irrigation, municipal, industrial)

WELL COMPLETION DATA:

- (1) diameter (inches) 2 1/2
- (2) total depth (feet) 60
- (3) static water level (feet) 4 below above top of ground.
- (4) casing ... (material) (depth)  
... If telescope see back. (size)
- (5) screen 4' (length) (depth to top)  
2' (size) (material)
- (6) pump 1 (HP) (yield gpm)  
... (type power)
- (7) electric log no (yes or no)  
... (organization running log)
- (8) how well bottom plugged 3 1/2'


DRILLERS REMARKS:

MAR 1 8 1976

MISS. Bd. of WATER COMM

If well telescopes please sketch and show depths.

GROUND LEVEL

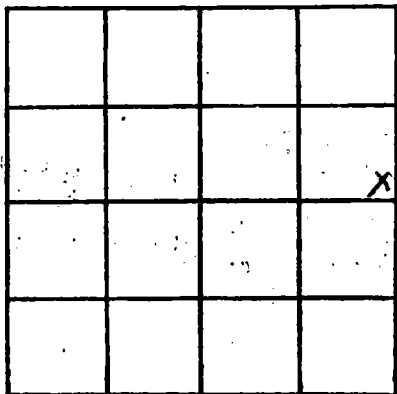

SECTION 2

Please indicate well location X.

ADDITIONAL INFORMATION

If more than one screen, show locations of each on sketch.