

Jackson
 D 9003
 10/27/76

MISSISSIPPI
 BOARD OF WATER COMMISSIONERS
 416 North State Street
 13R Jackson, Mississippi 39201

WATER WELL DRILLERS LOG

~~10/27/76~~ 10/27/76 date well completed
 Diff. Wells firm name
 Jackson county well located


LANDOWNER:	description of formations encountered	from	to
Dennis Bayles Rt. 3	yellow sand clay	0'	22'
Passagonala Miss (mailing address)	white sand	22'	40'
WELL LOCATION: sec. 23 T. 4 N. R. 5 E 2 miles N/E of Hurley (distance) (direction) (nearest town)	yellow clay sand	40'	65'
WELL PURPOSE: Home (home, irrigation, municipal, industrial)	blue clay	65'	105'
WELL COMPLETION DATA: (1) diameter (inches) 3" (2) total depth (feet) 140' (3) static water level (feet) 5 below top of ground. (4) casing PVL 135' (material) (depth) If telescope see back. (5) screen 5' 135' (length) (depth to top) 2" PVL (size) (material) (6) pump 1/2 10 (HP) (yield gpm) ele (type power) (7) electric log no (yes or no) (organization running log) (8) how well bottom plugged Bw	fine gray sand	105'	140'
DRILLERS REMARKS:			

RECEIVED
 DEC 6 1976

MISS. BD. OF WATER COM

If well telescopes please sketch and show depths.

GROUND LEVEL

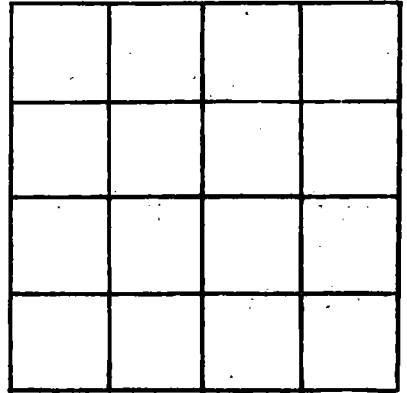

SECTION _____

Please indicate well location X.

ADDITIONAL INFORMATION

If more than one screen,
show locations of each on sketch.