

JACKSON
 D 2016
 12/31/76

MISSISSIPPI
 BOARD OF WATER COMMISSIONERS
 416 North State Street
 Jackson, Mississippi 39201

WATER WELL DRILLERS LOG

Dec 31 1976 W. H. H. Wells Co Cook
 date well completed firm name county well located

LANDOWNER: Earl Conroy
PL

description of formations encountered

1302
 (mailing address)

from 0' 8'
 to 8' 78"

WELL LOCATION:
 sec 6 T 4 N R 15 E
1/4 miles west of H. L. H. Wells
 (distance) (direction) (nearest town)

white yellow clay 18' 50"
 Blue clay 50'
 210'
 215'

WELL PURPOSE: Home
 (home, irrigation, municipal, industrial)

fine gray sand 210 229

WELL COMPLETION DATA:

- (1) diameter (inches) 2"
- (2) total depth (feet) 230'
- (3) static water level (feet) 90' below above top of ground.
- (4) casing PVC 220'
 (material) (depth)
2" If telescope see back.
 (size)
- (5) screen 10' 220'
 (length) (depth to top)
2" PVC
 (size) (material)
- (6) pump 1 10
 (HP) (yield gpm)
elc
 (type power)
- (7) electric log no
 (yes or no)
 (organization running log)
- (8) how well bottom plugged Back


DRILLERS REMARKS:

RECEIVED
 FEB - 7 1977

MISS. BD. OF WATER COMM

If well telescopes please sketch and show depths.

GROUND LEVEL

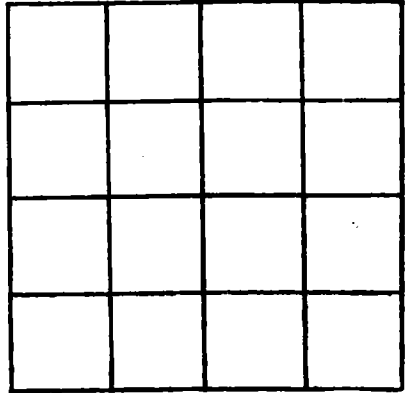

SECTION _____

Please indicate well location X.

ADDITIONAL INFORMATION

If more than one screen, show locations of each on sketch.