

JACKSON  
D 2007  
4/17/77

MISSISSIPPI  
BOARD OF WATER COMMISSIONERS  
416 North State Street  
Jackson, Mississippi - 39201

13R

WATER WELL DRILLERS LOG

4/17/77 1977 Triffin Well Co firm name Jackson county well located

LANDOWNER: Jerry Tanner

description of formations encountered

from to

RT-1

red clay 0' 25'

Wilma Ala  
(mailing address)

red sand 20'

WELL LOCATION:

sec. 1 T. 4 N. R. 5 E.  
3 miles South Smith  
(distance) (direction) (nearest town)

yellow & white clay streaks sand 25' 30'

red coarse sand 25' 28'

WELL PURPOSE: Home  
(home, irrigation, municipal, industrial)

WELL COMPLETION DATA:

(1) diameter (inches) 2"

(2) total depth (feet) 90'

(3) static water level (feet) 44 below above top of ground.

(4) casing Pvc 85'  
(material) (depth)

\_\_\_\_\_ If telescope see back.  
(size)

(5) screen 5' 85'  
(length) (depth to top)

2" Pvc  
(size) (material)

(6) pump 1 1.2  
(HP) (yield gpm)

eda  
(type power)

(7) electric log no  
(yes or no)

\_\_\_\_\_ (organization running log)

(8) how well bottom plugged BwK


DRILLERS REMARKS:

RECEIVED  
JUL 11 1977

MISS. BD. OF WATER COMMISSIONERS

If well telescopes please sketch and show depths.

GROUND LEVEL

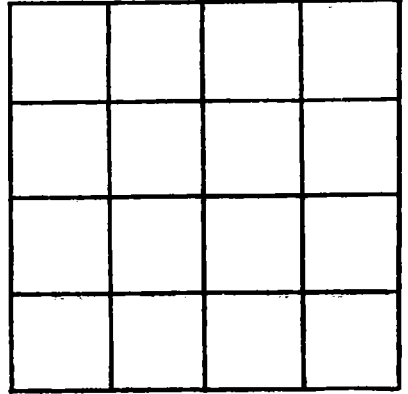

SECTION \_\_\_\_\_

Please indicate well location X.

ADDITIONAL INFORMATION

If more than one screen, show locations of each on sketch.