

JACKSON
D 2008
9-14-77

MISSISSIPPI
BOARD OF WATER COMMISSIONERS
416 North State Street
Jackson, Mississippi 39201

WATER WELL DRILLERS LOG

9/14/77 1977 22 Huff Well Co Jackson
date well completed firm name county well located

LANDOWNER:

J & E Cronier
Rt 3 Passenger
(mailing address)

WELL LOCATION:

sec 33 T 4 N R 5 E
in Harley of Harley
(distance) (direction) (nearest town)

WELL PURPOSE: Home
(home, irrigation, municipal, industrial)

WELL COMPLETION DATA:

- (1) diameter (inches) 2"
- (2) total depth (feet) 340'
- (3) static water level (feet) 48' below above top of ground.
- (4) casing PVC 320'
(material) (depth)
if telescope see back.
- (5) screen 10' 320'
(length) (depth to top)
2" PVC
(size) (material)
- (6) pump 1 12
(HP) (yield gpm)
elo
(type power)
- (7) electric log no
(yes or no)
(organization running log)
- (8) how well bottom plugged Brew, V.

description of formations encountered

from to

<u>red clay</u>	<u>0</u>	<u>18'</u>
<u>red sand</u>	<u>18'</u>	<u>26'</u>
<u>white sand & clay</u>	<u>26'</u>	<u>60'</u>
<u>light blue clay</u>	<u>60</u>	<u>90'</u>
<u>silt</u>	<u>90</u>	<u>100'</u>
<u>blue clay</u>	<u>100</u>	<u>320'</u>
<u>red long sand</u>	<u>320</u>	<u>340'</u>


RECEIVED
OCT - 7 1977

DRILLERS REMARKS:

MISS. BD. OF WATER COMMISSIONERS

If well telescopes please sketch and show depths.

GROUND LEVEL

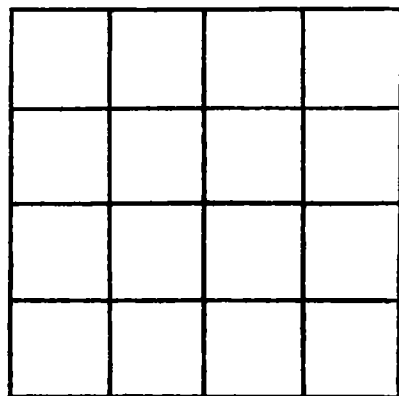

SECTION _____

Please indicate well location X.

ADDITIONAL INFORMATION

If more than one screen,
show locations of each on sketch.