

JACKSON
 D 2010
 4-17-78

MISSISSIPPI
 BOARD OF WATER COMMISSIONERS
 416 North State Street
 Jackson, Mississippi 39201

WATER WELL DRILLERS LOG

April 12 1978 Griff Well Co Jackson
 date well completed firm name county well located

LANDOWNER: Ronnie Pierce
~~Rt 2 Birmingham~~
Wilmer Ala
 (mailing address)

description of formations encountered	from	to
<u>red clay</u>	<u>0'</u>	<u>8'</u>
<u>sand & clay streaks</u>	<u>8'</u>	<u>20'</u>
<u>sand</u>	<u>20'</u>	<u>35'</u>

WELL LOCATION:
 sec 19 T 4 N R 4 E
3 miles West of Hurley
 (distance) (direction) (nearest town)

WELL PURPOSE: Home
 (home, irrigation, municipal, industrial)

- WELL COMPLETION DATA:
- (1) diameter (inches) 2"
 - (2) total depth (feet) 35'
 - (3) static water level (feet) 18' below top of ground
 - (4) casing PVC 30'
 (material) (depth)
 - (size) If telescope see back.
 - (5) screen 5' 30'
 (length) (depth to top)
 - (size) (material)
 - (6) pump 1/2 10
 (HP) (yield gpm)
 - ela
 (type power)
 - (7) electric log No
 (yes or no)
 - (organization running log)
 - (8) how well bottom plugged B.W.V.


DRILLERS REMARKS:

RECEIVED

MAY 5 - 1978

If well telescopes please sketch and show depths.

GROUND LEVEL

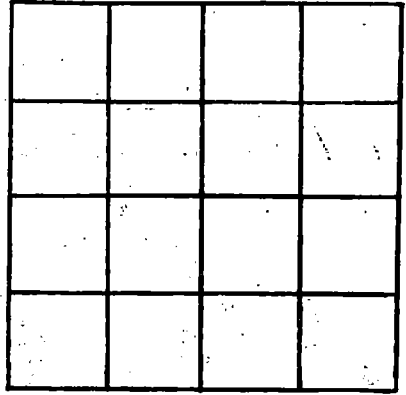

SECTION _____

Please indicate well location X.

ADDITIONAL INFORMATION

If more than one screen, show locations of each on sketch.