

JACKSON

D 7012

8-1-78

MISSISSIPPI BOARD OF WATER COMMISSIONERS. 416 North State Street Jackson, Mississippi 39201

WATER WELL DRILLERS LOG

8-1-78 date well completed

Coastal Water Well Serv. Inc. firm name

Jackson county well located

LANDOWNER: Amelia Gibson

P.O. Box 526

Miss Point, Miss. 39563 (mailing address)

WELL LOCATION:

sec. 29 T. 4 R. 5 2 miles North of Hurley (distance) (direction) (nearest town)

WELL PURPOSE: Home (home, irrigation, municipal, industrial)

WELL COMPLETION DATA:

- (1) diameter (inches) 2"
(2) total depth (feet) 398
(3) static water level (feet) 36' below top of ground
(4) casing PVC 388' (material) (depth)
(5) screen 10' 388' (length) (depth to top)
(6) pump 1 hp. 7 (HP) (yield gpm)
(7) electric log No (yes or no)

(organization running log)


(8) how well bottom plugged backwash valve

DRILLERS REMARKS:

description of formations encountered

from to

Table with 3 columns: description of formations encountered, from, to. Rows include Top soil, Red coarse sand & gravel, Blue Clay, White coarse sand, Blue Clay, Blue Clay & clamshell, Gray coarse sand, Blue Clay, Gray coarse sand.

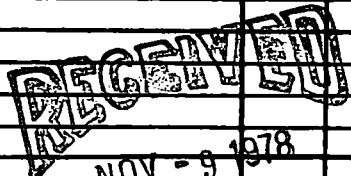

MISS. BD. OF WATER COMMISSIONERS

