

JACKSON
 D 7013
 11-15-78

MISSISSIPPI
 BOARD OF WATER COMMISSIONERS
 416 North State Street
 Jackson, Mississippi 39201

WATER WELL DRILLERS LOG

Jackson

11/15 1978 Pine Drilling Co. George
 date well completed firm name county well located

LANDOWNER: Lorne Miller
P.O. Box 442
Pascagoula, MS 39552
 (mailing address)

description of formations encountered	from	to
TOP SOIL	0	15
CLAY + SAND	15	20
GOOD SAND	20	50
CLAY	50	60
GOOD SAND	60	74

WELL LOCATION:
 sec. 28 T 4 N R 5 E
15 miles NORTH of Pascagoula
 (distance) (direction) (nearest town)

WELL PURPOSE:
 (home, irrigation, municipal, industrial)

WELL COMPLETION DATA:

(1) diameter (inches) 2"

(2) total depth (feet) 74'

(3) static water level (feet) 30' below top of ground

(4) casing Plastic 64'
 (material) (depth)

0 if telescope see back.
 (size)

(5) screen 10' to 74'
 (length) (depth to top)

0/10 Plastic
 (size) (material)

(6) pump 1 12
 (HP) (yield gpm)

3/4
 (type power)

(7) electric log yes
 (yes or no)

 (organization running log)

(8) how well bottom plugged BW.

DRILLERS REMARKS:


RECEIVED

DEC 18 1978

MISS. BD. OF WATER COMMISSIONERS

If well telescopes please sketch and show depths.

GROUND LEVEL

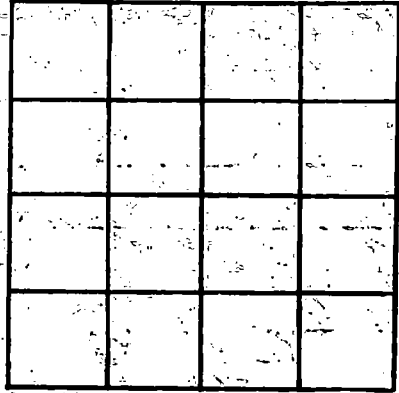

SECTION _____

Please indicate well location X.

ADDITIONAL INFORMATION

If more than one screen, show locations of each on sketch.