

Jackson
 D 7016
 3/28/79
 March 28

MISSISSIPPI
 BOARD OF WATER COMMISSIONERS
 416 North State Street
 Jackson, Mississippi 39201

WATER WELL DRILLERS LOG

1979 Griffin Well Co Jackson
 firm name county well located

| LANDOWNER: <u>Charles Glover</u> | description of formations encountered | from | to |
|--|---------------------------------------|-------------|-------------|
| <u>Mobile Ala</u> (mailing address) | <u>red sand clay</u> | <u>0'</u> | <u>15'</u> |
| | <u>sand</u> | <u>15'</u> | <u>20'</u> |
| WELL LOCATION: sec <u>6</u> T <u>4</u> N R <u>5</u> E <u>1</u> miles <u>West</u> of <u>Harleston</u> (distance) (direction) (nearest town) | <u>gray clay</u> | <u>25'</u> | <u>20'</u> |
| WELL PURPOSE: <u>Home</u> (home, irrigation, municipal, industrial) | <u>fine sand</u> | <u>20'</u> | <u>25'</u> |
| WELL COMPLETION DATA: (1) diameter (inches) <u>3"</u> (2) total depth (feet) <u>133'</u> (3) static water level (feet) <u>45'</u> below top of ground (4) casing <u>PVC</u> <u>128'</u> (material) (depth) (size) If telescope see back. (5) screen <u>5'</u> <u>128'</u> (length) (depth to top) <u>3"</u> <u>PVC</u> (size) (material) (6) pump <u>1</u> <u>12</u> (HP) (yield gpm) <u>ele</u> (type power) (7) electric log <u>no</u> (yes or no) (organization running log) (8) how well bottom plugged <u>BWV</u> | <u>Blue Clay</u> | <u>25'</u> | <u>120'</u> |
| | <u>gray sand</u> | <u>120'</u> | <u>133'</u> |

DRILLERS REMARKS:

Miss. Board of Water Comm.


APR 5 - 1979

RECEIVED

If well telescopes please sketch and show depths.

GROUND LEVEL

Surface flow

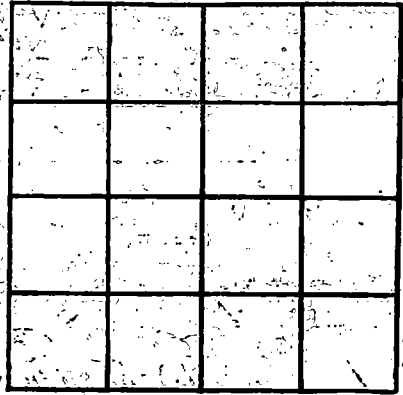

SECTION _____

Please indicate well location 'X'.

ADDITIONAL INFORMATION

If more than one screen, show locations of each on sketch.