

JACKSON  
D 2017  
5-20-79

MISSISSIPPI  
BOARD OF WATER COMMISSIONERS  
416 North State Street  
Jackson, Mississippi 39201

WATER WELL DRILLERS LOG

May 20 1979 date well completed  
Griffin Well Co firm name  
Jackson county well located

LANDOWNER:	description of formations encountered	from	to
Stanley Smith	red clay sand	0'	18'
Mass Point Miss (mailing address)	sand	18'	30'
WELL LOCATION: sec 31 T 4 N R 5 E 2 miles West of Hurley (distance) (direction) (nearest town)	yellow clay	30'	48'
WELL PURPOSE: Home (home, irrigation, municipal, industrial)	sand	48'	66'
WELL COMPLETION DATA:	Blue Clay	66'	3/0
(1) diameter (inches) 2 1/2			3/0
(2) total depth (feet) 345'			
(3) static water level (feet) 2 below top of ground			
(4) casing PVC 340' (depth)	gray sand	3/0	J45
(size) If telescope see back.			
(5) screen 5' (length) 340' (depth to top)			
(size) 2 1/2 (material) PVC			
(6) pump 1 (HP) 20 (yield gpm)			
(type power) elc			
(7) electric log no (yes or no)			
(organization running log)			
(8) how well bottom plugged Bulk			
DRILLERS REMARKS:			


Miss. Board of Water Comm.

JUN - 6 1979

RECEIVED

If well telescopes please sketch and show depths.

GROUND LEVEL

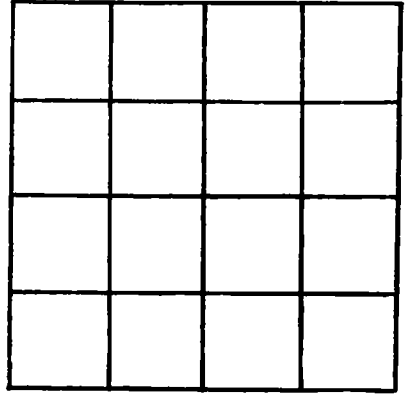

SECTION \_\_\_\_\_

Please indicate well location X.

ADDITIONAL INFORMATION

If more than one screen,  
show locations of each on sketch.