

Jackson
 D 20901
 9-3-80

MISSISSIPPI
 BOARD OF WATER COMMISSIONERS
 416 North State Street
 Jackson, Mississippi 39201

WATER WELL DRILLERS LOG

9-3-80 date well completed
 Pierce Drilling Co. firm name
 Jackson county well located

LANDOWNER: Bud Breland
 P.O. Bx.
 Hurley, Ms
 (mailing address)

description of formations encountered	from	to
TOP soil	0	10
Sand	10	20
Clay	20	25
Good Sand	25	45

WELL LOCATION:
 sec. 35 T. 4 N R. 5 E
 1.8 miles South of Lucedale
 (distance) (direction) (nearest town)

WELL PURPOSE:
 (home irrigation, municipal, industrial)

- WELL COMPLETION DATA:
- (1) diameter (inches) 2"
 - (2) total depth (feet) 45'
 - (3) static water level (feet) 20' ^{below} top of ground
 - (4) casing Plastic, 40' (material) (depth)
 - 0 (size) if telescope see back.
 - (5) screen 5' 45' (length) (depth to top)
 - 0.10 Plastic (size) (material)
 - (6) pump 1 9 (HP) (yield gpm)
 - Electric (type power)
 - (7) electric log (yes or no)
 - (organization running log)
 - (8) how well bottom plugged BW

DRILLERS REMARKS:


DEPT. OF NATURAL RESOURCES
 BUREAU OF LAND & WATER RESOURCES

JAN 28 1981

RECEIVED

If well telescopes please sketch and show depths.

GROUND LEVEL

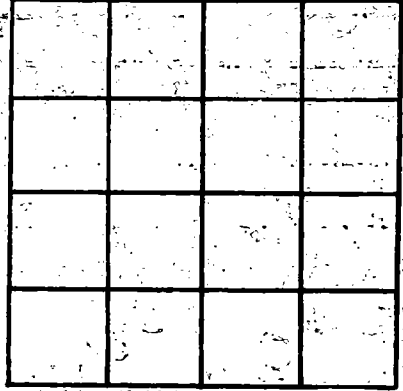

SECTION _____

Please indicate well location X.

ADDITIONAL INFORMATION

If more than one screen, show locations of each on sketch.