

**MISSISSIPPI DEPARTMENT OF NATURAL RESOURCES**  
**Bureau of Land and Water Resources**  
 Southport Mall  
 P.O. Box 10631  
 Jackson, Mississippi 39209  
**WATER WELL DRILLERS LOG**

**JACKSON**  
**D 2026**  
**8-29-81**

8-29 1981 Pierce Drilling Co. Jackson  
 date well completed firm name county well located

**LANDOWNER:** Gene Roberts  
 ↓  
Pascagoula, Ms  
 (mailing address)


description of formations encountered	from to	
<u>TOP soil</u>	<u>0</u>	<u>10</u>
<u>Sand</u>	<u>10</u>	<u>20</u>
<u>Clay</u>	<u>20</u>	<u>25</u>
<u>Coold Sand</u>	<u>25</u>	<u>35</u>

**WELL LOCATION:**  
 sec. 7 T. 4 N R. 5 E  
2.5 miles South of Porton  
 (distance) (direction) (nearest town)

**WELL PURPOSE:**  
 (home, irrigation, municipal, industrial)


- WELL COMPLETION DATA:**
- (1) diameter (inches) 2"
  - (2) total depth (feet) 35'
  - (3) static water level (feet) 20' below top of ground. above
  - (4) casing Plastic, 30'  
 (material) (depth)  
0 If telescope see back.  
 (size)
  - (5) screen 5', 35'  
 (length) (depth to top)  
008, Plastic  
 (size) (material)
  - (6) pump 1 6  
 (HP) (yield gpm)  
Electric  
 (type power)
  - (7) electric log yes or no  
 (organization running log)
  - (8) how well bottom plugged BW

**DRILLERS REMARKS:**

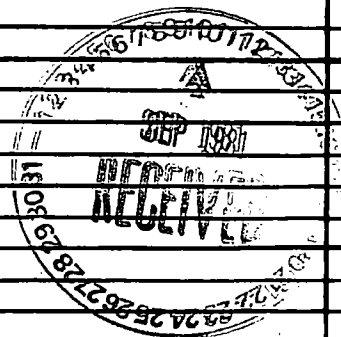

If well telescopes please sketch and show depths.

GROUND LEVEL

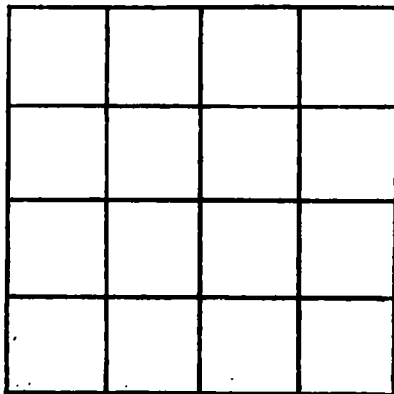

SECTION \_\_\_\_\_

Please indicate well location X.

ADDITIONAL INFORMATION

If more than one screen, show locations of each on sketch.