

MISSISSIPPI DEPARTMENT OF NATURAL RESOURCES

Bureau of Land and Water Resources

Southport Mall

P.O. Box 10631

Jackson, Mississippi 39209

WATER WELL DRILLERS LOG

Jackson
D 2078

11-3 1981 Pierce Drilling Co. Jackson
date well completed firm name county well located

LANDOWNER: <u>Elise Adkinson</u>	description of formations encountered	from	to
<u>Hurley Ms</u> (mailing address)		<u>Top Soil</u> <u>Good Sand</u>	<u>0</u> <u>10</u>
WELL LOCATION: sec <u>31</u> T <u>4</u> N R <u>5</u> <u>Hurley</u> <u>35</u> miles <u>South</u> of <u>Kosciusko</u> (distance) (direction) (nearest town)			
WELL PURPOSE: (Home, Irrigation, municipal, industrial)			
WELL COMPLETION DATA:			
(1) diameter (inches) <u>2"</u>			
(2) total depth (feet) <u>75'</u>			
(3) static water level (feet) <u>20'</u> ^{below} above top of ground.			
(4) casing <u>Plastic</u> , <u>65</u> (material) (depth)			
<u>0</u> if telescope see back. (size)			
(5) screen <u>10'</u> , <u>75'</u> (length) (depth to top)			
<u>208</u> , <u>Plastic</u> (size) (material)			
(6) pump <u>1</u> <u>10</u> (HP) (yield gpm)			
<u>Electric</u> (type power)			
(7) electric log (yes or no)			
(organization running log)			
(8) how well bottom plugged <u>BW</u>			

DEPT. OF NATURAL RESOURCES
BUREAU OF LAND & WATER RESOURCES


MAR 11 1982

RECEIVED

DRILLERS REMARKS:

If well telescopes please sketch and show depths.

GROUND LEVEL

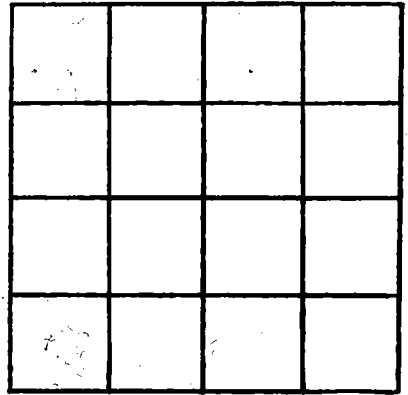

SECTION _____

Please indicate well location X.

ADDITIONAL INFORMATION

If more than one screen, show locations of each on sketch.