

MISSISSIPPI DEPARTMENT OF NATURAL RESOURCES

Bureau of Land and Water Resources

Southport Mall

P.O. Box 10631

Jackson, Mississippi 39209

WATER WELL DRILLERS LOG

Jackson
D 2030

8-12 1982 Pierce Drilling Co. Jackson
date well completed firm name county well located

LANDOWNER: <u>J. C. Lander</u>	description of formations encountered	from	to
<u>Hurley, Ms</u> (mailing address)	<u>Top Soil</u> <u>Good Sand</u>	<u>0</u> <u>10</u>	<u>10</u> <u>45</u>
WELL LOCATION: sec. <u>29</u> T <u>4</u> N R. <u>5</u> E <u>1</u> miles <u>North</u> of <u>Hurley</u> (distance) (direction) (nearest town)			
WELL PURPOSE: (<u>home</u> irrigation, municipal, industrial)			
WELL COMPLETION DATA: (1) diameter (inches) <u>2"</u> (2) total depth (feet) <u>45'</u> (3) static water level (feet) <u>8'</u> <u>below</u> above top of ground. (4) casing <u>plastic</u> , <u>40'</u> (material) (depth) <u>0</u> if telescope see back. (size) (5) screen <u>5'</u> , <u>45'</u> (length) (depth to top) <u>008</u> , <u>Plastic</u> (size) (material) (6) pump <u>1</u> <u>10</u> (HP) (yield gpm) <u>Electric</u> (type power) (7) electric log (yes or no) (organization running log) (8) how well bottom plugged <u>BW</u>			
DRILLERS REMARKS:			


DEPT. OF NATURAL RESOURCES
BUREAU OF LAND & WATER RESOURCES

SEP 21 1982

RECEIVED

If well telescopes please sketch and show depths.

GROUND LEVEL

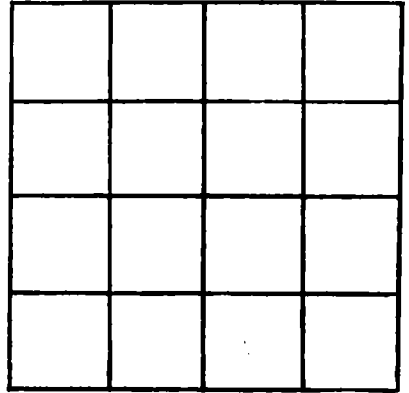

SECTION _____

Please indicate well location X.

ADDITIONAL INFORMATION

If more than one screen, show locations of each on sketch.