

MISSISSIPPI DEPARTMENT OF NATURAL RESOURCES

Bureau of Land and Water Resources

Southport Mall

P.O. Box 10631

Jackson, Mississippi 39209

WATER WELL DRILLERS LOG

Jackson
D 20.31

8-14 1982 Pierce Drilling Co. Jackson
date well completed firm name county well located

LANDOWNER: Lance Jones

description of formations encountered

from

to

Harley Ms
(mailing address)

Top Soil	0	10
Good Sand	10	26

WELL LOCATION:

sec. 32 T 4 N R 5 E
1 miles West of Harley
(distance) (direction) (nearest town)

WELL PURPOSE:

(home) Irrigation, municipal, industrial

WELL COMPLETION DATA:

- (1) diameter (inches) 1 1/4"
- (2) total depth (feet) 26'
- (3) static water level (feet) 8' below above top of ground.
- (4) casing Plastic 21' (material) (depth)
- 0 (size) If telescope see back.
- (5) screen 5' 26' (length) (depth to top)
- 008 Plastic (size) (material)
- (6) pump 3 8 (HP) (yield gpm)
- Electric (type power)
- (7) electric log (yes or no)

(organization running log)

(8) how well bottom plugged BW

DEPT. OF NATURAL RESOURCES
BUREAU OF LAND & WATER RESOURCES


SEP 21 1982

RECEIVED

DRILLERS REMARKS:

If well telescopes please sketch and show depths.

GROUND LEVEL

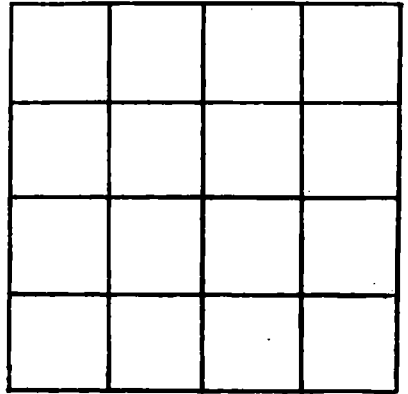

SECTION _____

Please indicate well location X.

ADDITIONAL INFORMATION

If more than one screen, show locations of each on sketch.