

MISSISSIPPI DEPARTMENT OF NATURAL RESOURCES

Bureau of Land and Water Resources

Southport Mall

P.O. Box 10631

Jackson, Mississippi 39209

WATER WELL DRILLERS LOG

Jackson  
D 2032

3-18 1983 Pierce Drilling Co. Jackson  
date well completed firm name county well located

LANDOWNER: <u>John W. Bush</u>	description of formations encountered	from	to
<u>P.O. Box 6</u>			
<u>Hurley, Ms</u> (mailing address)	<u>Top Soil</u>	<u>0</u>	<u>10</u>
	<u>Sand &amp; Clay</u>	<u>10</u>	<u>20</u>
	<u>Good Sand</u>	<u>20</u>	<u>45</u>

WELL LOCATION:  
sec. 31T-4 N R-5 E  
3 miles West of Hurley  
(distance) (direction) (nearest town)

WELL PURPOSE:  
(home, irrigation, municipal, industrial)

- WELL COMPLETION DATA:
- (1) diameter (inches) 2"
  - (2) total depth (feet) 45'
  - (3) static water level (feet) 20' below top of ground. above
  - (4) casing Plastic, 40'  
(material) (depth)
  - 0 (size) if telescope see back.
  - (5) screen 5 (length) 45' (depth to top)
  - 006 (size) Plastic (material)
  - (6) pump 1 (HP) 10 (yield gpm)
  - Electric (type power)
  - (7) electric log (yes or no)
  - (organization running log)
  - (8) how well bottom plugged BW

DRILLERS REMARKS:


DEPT. OF NATURAL RESOURCES  
BUREAU OF LAND & WATER RESOURCES

MAY 24 1983

RECEIVED

If well telescopes please sketch and show depths.

GROUND LEVEL

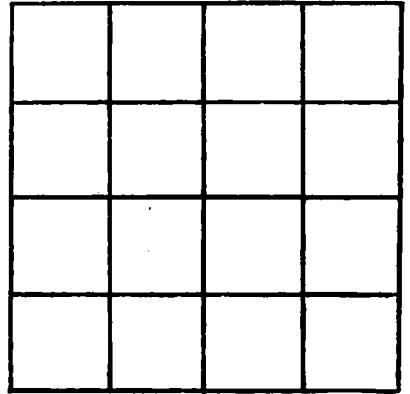

SECTION \_\_\_\_\_

Please indicate well location X.

ADDITIONAL INFORMATION

If more than one screen, show locations of each on sketch.