

MISSISSIPPI DEPARTMENT OF NATURAL RESOURCES

Bureau of Land and Water Resources

Southport Mall

P.O. Box 10631

Jackson, Mississippi 39209

WATER WELL DRILLERS LOG

Jackson
D 2034

9-25, 1983 Perce Drilling Co. Jackson
date well completed firm name county well located

LANDOWNER: James Daniels

description of formations encountered	from	to
<u>Top soil</u>	<u>0</u>	<u>10</u>
<u>Sand & Clay</u>	<u>10</u>	<u>25</u>
<u>Coar. sand</u>	<u>25</u>	<u>50</u>

Hurley, Ms
(mailing address)

WELL LOCATION:
sec. 29 T. 4 N. R. 5 E
1 miles East of Hurley
(distance) (direction) (nearest town)

WELL PURPOSE:
(home) Irrigation, municipal, industrial

- WELL COMPLETION DATA:
- (1) diameter (inches) 2"
 - (2) total depth (feet) 50'
 - (3) static water level (feet) 20' below above top of ground.
 - (4) casing Plastic, 40'
(material) (depth)
0 If telescope see back.
(size)
 - (5) screen 10', 50'
(length) (depth to top)
1006, Plastic
(size) (material)
 - (6) pump 1 10
(HP) (yield gpm)
Electric
(type power)
 - (7) electric log (yes or no)

(organization running log)

(8) how well bottom plugged BW

DRILLERS REMARKS:


DEPT. OF NATURAL RESOURCES
BUREAU OF LAND & WATER RESOURCES

FEB - 1 1984

RECEIVED

If well telescopes please sketch and show depths.

GROUND LEVEL

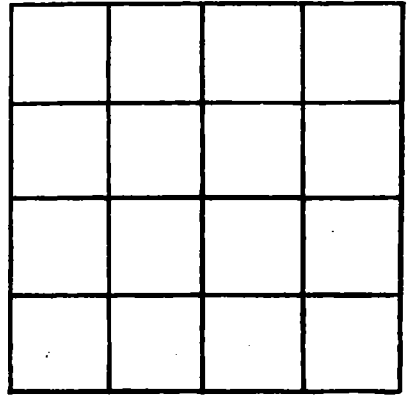

SECTION _____

Please indicate well location X.

ADDITIONAL INFORMATION

If more than one screen, show locations of each on sketch.