

BOARD OF WATER COMMISSIONERS
416 North State Street
Jackson, Mississippi 39201

2039

WATER WELL DRILLERS LOG

date well completed 12-17 1984

firm name Pierce Drilling Co.

county well located Jackson

LANDOWNER: Margaret Vise

Harleston, ms
(mailing address)

WELL LOCATION:

sec. 6 T. 4 N. R. 5 E.
(distance) (direction) (nearest town)
1 miles west of Harleston

WELL PURPOSE:

(home) irrigation, municipal, industrial

WELL COMPLETION DATA:

- (1) diameter (inches) 2"
- (2) total depth (feet) 105'
- (3) static water level (feet) 50' below above top of ground.
- (4) casing plastic, 100'
(material) (depth)
- 0 if telescope see back.
(size)
- (5) screen 5', 105'
(length) (depth to top)
- 006, plastic
(size) (material)
- (6) pump 1 (HP), 10 (yield gpm)
- electric
(type power)
- (7) electric log (yes or no)
- (organization running log)
- (8) how well bottom plugged AW

description of formations encountered

from

to

<u>Top soil</u>	<u>0</u>	<u>10</u>
<u>Clay</u>	<u>10</u>	<u>20</u>
<u>good sand</u>	<u>20</u>	<u>35</u>
<u>Clay</u>	<u>35</u>	<u>90</u>
<u>good sand</u>	<u>90</u>	<u>105</u>


DRILLERS REMARKS:

RECEIVED

MAR 21 1985

If well telescopes please
sketch and show depths.

GROUND LEVEL

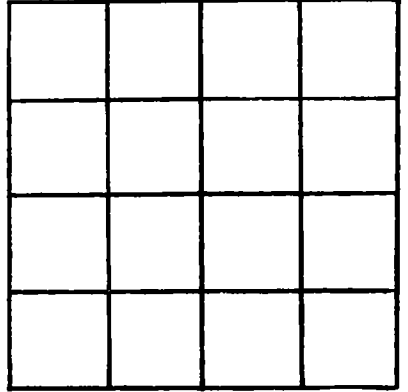

SECTION _____

Please indicate well location X.

ADDITIONAL INFORMATION

If more than one screen,
show locations of each on sketch.