

BOARD OF WATER COMMISSIONERS
416 North State Street
Jackson, Mississippi 39201

WATER WELL DRILLERS LOG

1-9 1985 date well completed Pruce Drilling firm name Jackson county well located

LANDOWNER: Rhonda Jones

description of fomations encountered	from	to
<u>top soil</u>	<u>0</u>	<u>10</u>
<u>clay</u>	<u>10</u>	<u>20</u>
<u>good sand</u>	<u>20</u>	<u>35</u>

Hurley, Ms
(mailing address)

WELL LOCATION:
sec. 20 T. 4 N. R. 5 E
3 miles South of Harleston
(distance) (direction) (nearest town)

WELL PURPOSE:
(home) irrigation, municipal, industrial)

WELL COMPLETION DATA:

- (1) diameter (Inches) 2"
- (2) total depth (feet) 35'
- (3) static water level (feet) 10' below above top of ground.
- (4) casing plastic, 30'
(material) (depth)
0 if telescope see back.
(size)
- (5) screen 5', 35'
(length) (depth to top)
006, plastic
(size) (material)
- (6) pump 1/2 6
(HP) (yield gpm)
electric
(type power)
- (7) electric log (yes or no)
(organization running log)
- (8) how well bottom plugged BW


DRILLERS REMARKS: _____

RECEIVED

MAR 21 1985

If well telescopes please sketch and show depths.

GROUND LEVEL

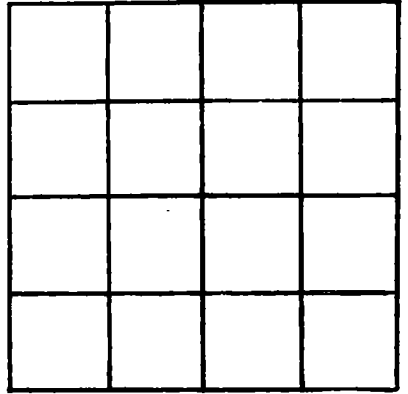

SECTION _____

Please indicate well location X.

ADDITIONAL INFORMATION

If more than one screen, show locations of each on sketch.