

BOARD OF WATER COMMISSIONERS  
416 North State Street  
Jackson, Mississippi 39201

JACKSON  
D 2041

WATER WELL DRILLERS LOG

3-12-85 date well completed Pierce Drilling firm name Jackson county well located

LANDOWNER: Bobby E. Nelson

description of formations encountered	from	to
<u>Top soil</u>	<u>0</u>	<u>10</u>
<u>Sand + Clay</u>	<u>10</u>	<u>20</u>
<u>good sand</u>	<u>20</u>	<u>45</u>

Hurley, MS  
(mailing address)

WELL LOCATION:  
sec. 27 T 4 N R 5 E  
1 miles east of Hurley  
(distance) (direction) (nearest town)

WELL PURPOSE:  
(home, irrigation, municipal, industrial)


- WELL COMPLETION DATA:
- (1) diameter (inches) 2"
  - (2) total depth (feet) 45'
  - (3) static water level (feet) 20' <sup>below</sup> above top of ground.
  - (4) casing plastic, 40'  
(material) (depth)
  - 0 if telescope see back.  
(size)
  - (5) screen 5', 45'  
(length) (depth to top)
  - 006, plastic  
(size) (material)
  - (6) pump 1 10  
(HP) (yield gpm)
  - electric  
(type power)
  - (7) electric log yes or (no)  
  
(organization running log)
  - (8) how well bottom plugged BW

DRILLERS REMARKS:

RECEIVED  
MAR 27 1985

If well telescopes please sketch and show depths.

GROUND LEVEL

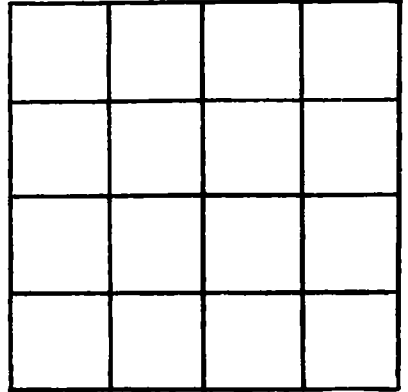

SECTION \_\_\_\_\_

Please indicate well location X.

ADDITIONAL INFORMATION

If more than one screen,  
show locations of each on sketch.