

Jackson
 D 2042
 5-7-85

MISSISSIPPI
 BOARD OF WATER COMMISSIONERS
 416 North State Street
 Jackson, Mississippi 39201

L

WATER WELL DRILLERS LOG

5-7 1985 Pierce Drilling Jackson
 date well completed firm name county well located


LANDOWNER: <u>James Dwyer</u>	description of formations encountered	from	to
<u>Hurley, ms</u> (mailing address)	<u>top soil</u> <u>Clay</u> <u>good sand</u>	0 10 20	10 20 25
WELL LOCATION: sec. <u>33</u> -T- <u>4</u> N R- <u>5</u> E (distance) miles (direction) of <u>in Hurley</u> (nearest town)			
WELL PURPOSE: <u>Business</u> (home, irrigation, municipal, industrial)			
WELL COMPLETION DATA:			
(1) diameter (Inches) <u>2"</u>			
(2) total depth (feet) <u>45'</u>			
(3) static water level (feet) <u>18'</u> <u>below</u> above top of ground.			
(4) casing <u>plastic</u> , <u>40'</u> (material) (depth)			
<u>0</u> if telescope see back. (size)			
(5) screen <u>5'</u> , <u>45'</u> (length) (depth to top)			
<u>006</u> , <u>plastic</u> (size) (material)			
(6) pump <u>1</u> <u>12</u> (HP) (yield gpm)			
<u>electric</u> (type power)			
(7) electric log <u>(yes or no)</u>			
(organization running log)			
(8) how well bottom plugged <u>BW</u>			
DRILLERS REMARKS:			

RECEIVED
 JUL 28 1985

Department of Natural Resources
 Bureau of Land & Water Resources

If well telescopes please sketch and show depths.

GROUND LEVEL

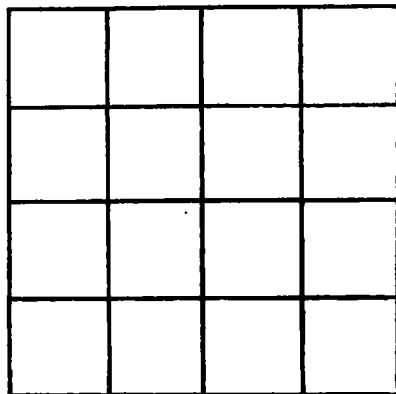

SECTION _____

Please indicate well location X.

ADDITIONAL INFORMATION

If more than one screen,
show locations of each on sketch.