

Jackson
 D 2043
 6-18-85

MISSISSIPPI
 BOARD OF WATER COMMISSIONERS
 416 North State Street
 Jackson, Mississippi 39201

L

WATER WELL DRILLERS LOG

6-18-1985 Pierce Drilling Jackson
 date well completed firm name county well located

LANDOWNER: Herman Finch
P.O. Bx 478
Hurley Ms
 (mailing address)

description of formations encountered	from	to
<u>Top soil</u>	<u>0</u>	<u>10</u>
<u>Sand & Clay</u>	<u>10</u>	<u>20</u>
<u>good Sand</u>	<u>20</u>	<u>50</u>

WELL LOCATION:
 sec. 30 T. 4 N R. 5 E
2 miles West of Hurley
 (distance) (direction) (nearest town)

WELL PURPOSE:
 (home, irrigation, municipal, industrial)

WELL COMPLETION DATA:

(1) diameter (Inches) 2"

(2) total depth (feet) 50'

(3) static water level (feet) 20' below above top of ground.

(4) casing plastic, 45'
 (material) (depth)

0 if telescope see back.
 (size)

(5) screen 5', 50'
 (length) (depth to top)

006, plastic
 (size) (material)

(6) pump 1 10
 (HP) (yield gpm)

electric
 (type power)

(7) electric log (yes or no)

(organization running log)

(8) how well bottom plugged BW


RECEIVED
 JUL 23 1985

DRILLERS REMARKS:

Department of Natural Resources
 Bureau of Land & Water Resources

If well telescopes please sketch and show depths.

GROUND LEVEL

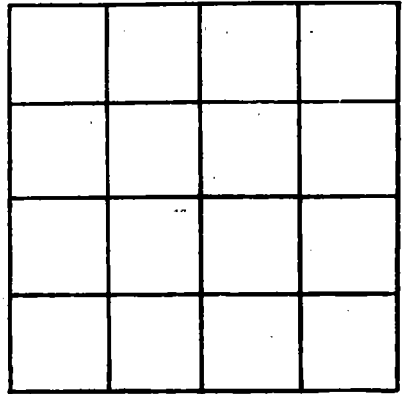

SECTION _____

Please indicate well location X.

ADDITIONAL INFORMATION

Lined area for additional information.

If more than one screen, show locations of each on sketch.