

Jackson
 D 2044
 6-15-85

MISSISSIPPI
 BOARD OF WATER COMMISSIONERS
 416 North State Street
 Jackson, Mississippi 39201

L

WATER WELL DRILLERS LOG

6-15 1985 Pierce Drilling Co. Jackson
 date well completed firm name county well located

LANDOWNER: E. L. Loftin
 3820 Wilson Spring Rd.
 Passapatan, ms
 (mailing address)

description of formations encountered	from	to
top soil	0	10
Sand & Clay	10	20
good Sand	20	40

WELL LOCATION:
 sec. 30 T 4 N R 5 E
 2 miles West of Huxley
 (distance) (direction) (nearest town)

WELL PURPOSE:
 (home, irrigation, municipal, industrial)

- WELL COMPLETION DATA:
- (1) diameter (inches) 2'
 - (2) total depth (feet) 40'
 - (3) static water level (feet) 20' below above top of ground.
 - (4) casing plastic, 35' (material) (depth)
 - 0 (size) if telescope see back.
 - (5) screen 5' 40' (length) (depth to top)
 - 006 plastic (size) (material)
 - (6) pump 1 (HP) 10 (yield gpm)
 - electric (type power)
 - (7) electric log (yes or no)
 - (organization running log)
 - (8) how well bottom plugged BW

DRILLERS REMARKS:


RECEIVED

JUL 23 1985

Department of Natural Resources
 Bureau of Land & Water Resources

If well telescopes please sketch and show depths.

GROUND LEVEL

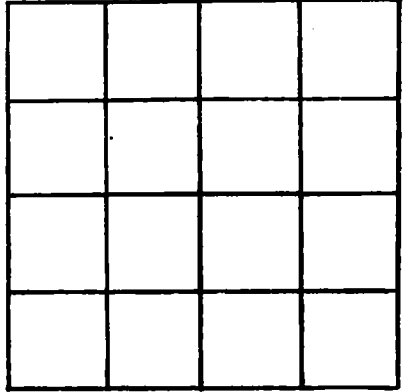

SECTION _____

Please indicate well location X.

ADDITIONAL INFORMATION

If more than one screen, show locations of each on sketch.