

Jackson  
 D 2045  
 6-28-85

MISSISSIPPI  
 BOARD OF WATER COMMISSIONERS  
 416 North State Street  
 Jackson, Mississippi 39201

L

WATER WELL DRILLERS LOG

6-28 1985 Pierce Drilling Jackson  
 date well completed firm name county well located

LANDOWNER: C.J. Carter

description of formations encountered

from

to

Hurley, ms  
 (mailing address)

Top soil  
 good sand

0 10  
 10 20

WELL LOCATION:

sec. 32 T. 4 N R. 5 E  
 (S) (W)  
 2 miles east of Hurley  
 (distance) (direction) (nearest town)

WELL PURPOSE:

(home, irrigation, municipal, industrial)

WELL COMPLETION DATA:

- (1) diameter (inches) 2"
- (2) total depth (feet) 20'
- (3) static water level (feet) 10 <sup>below</sup> <sub>above</sub> top of ground.
- (4) casing plastic, 15'  
 (material) (depth)
- 0  
 (size) if telescope see back.
- (5) screen 5', 20'  
 (length) (depth to top)
- 000 plastic  
 (size) (material)
- (6) pump 1 (HP) 6 (yield gpm)  
 electric  
 (type power)
- (7) electric log (yes or no)

(organization running log)

(8) how well bottom plugged Beu


RECEIVED

JUL 23 1985

DRILLERS REMARKS:

If well telescopes please sketch and show depths.

GROUND LEVEL

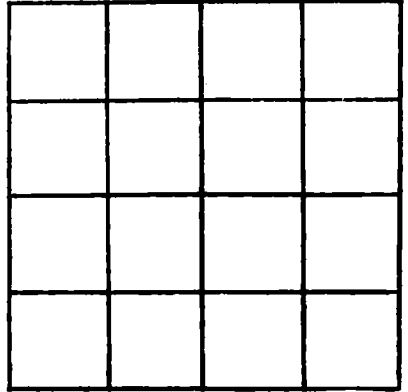

SECTION \_\_\_\_\_

Please indicate well location X.

ADDITIONAL INFORMATION

If more than one screen, show locations of each on sketch.