

Jackson  
 D 2046  
 7-10-85

MISSISSIPPI  
 BOARD OF WATER COMMISSIONERS  
 416 North State Street  
 Jackson, Mississippi 39201

L

WATER WELL DRILLERS LOG

7-10-1985 date well completed  
 Pierce Drilling firm name  
 Jackson county well located

LANDOWNER: B.P. Roar

description of formations encountered	from	to
	top soil	0
Sand + Clay	10	20
Clay	20	30
good sand	30	58

Hurley, Ms (mailing address)

WELL LOCATION:  
 sec. 29 T. 4 N R. 5 E  
 2 miles West of Hurley  
 (distance) (direction) (nearest town)

WELL PURPOSE:  
 (home) Irrigation, municipal, industrial

WELL COMPLETION DATA:

- (1) diameter (inches) 2"
- (2) total depth (feet) 58'
- (3) static water level (feet) 20' below top of ground.
- (4) casing plastic, 53' (material) (depth)
- (size) if telescope see back.
- (5) screen 5' 38' (length) (depth to top)
- 806 plastic (size) (material)
- (6) pump 1 (HP) 10 (yield gpm)
- electric (type power)
- (7) electric log (yes or no)
- (organization running log)
- (8) how well bottom plugged BU


RECEIVED  
 JUL 23 1985

DRILLERS REMARKS:

Department of Natural Resources  
 Bureau of Land & Water Resources

If well telescopes please sketch and show depths.

GROUND LEVEL

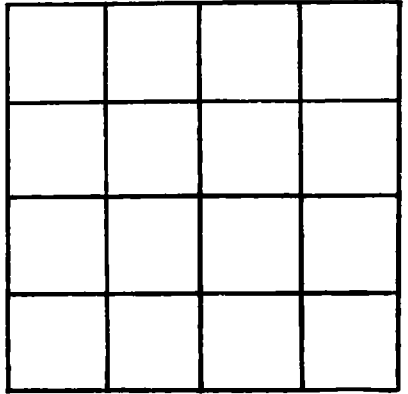

SECTION \_\_\_\_\_

Please indicate well location X.

ADDITIONAL INFORMATION

If more than one screen, show locations of each on sketch.