

MISSISSIPPI DEPARTMENT OF NATURAL RESOURCES

Bureau of Land and Water Resources

Southport Mall

P.O. Box 10631

Jackson, Mississippi 39209

WATER WELL DRILLERS LOG

JACKSON
D 2097

9-7-85 Pierce Drilling Co. Jackson
date well completed firm name county well located

LANDOWNER: Bruce Hamilton

description of formations encountered	depth	
	from	to
top soil	0	5
clay	5	15
good sand	15	30


Hurley Ms
(mailing address)

WELL LOCATION:
sec. 29 T 4 N R 5 E
7 miles West of Marble Hill
(distance) (direction) (nearest town)

WELL PURPOSE:
(home) Irrigation, municipal, Industrial

WELL COMPLETION DATA:

- (1) diameter (inches) 2"
- (2) total depth (feet) 30'
- (3) static water level (feet) 15' below above top of ground.
- (4) casing plastic, 25'
(material) (depth)
- 4 If telescope see back.
(size)
- (5) screen 5', 30'
(length) (depth to top)
- 20g, plastic
(size) (material)
- (6) pump 1 12
(HP) (yield gpm)
- electric
(type power)
- (7) electric log (yes or no)
(organization running log)
- (8) how well bottom plugged BW

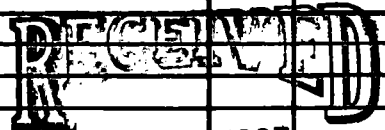


NOV 19 1985

DRILLERS REMARKS:

Department of Natural Resources
Bureau of Land & Water Resources

If well telescopes please sketch and show depths.

GROUND LEVEL

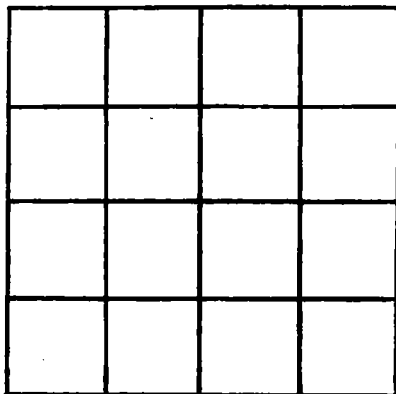

SECTION _____

Please indicate well location X.

ADDITIONAL INFORMATION

A series of horizontal lines providing space for additional information.

If more than one screen, show locations of each on sketch.