

MISSISSIPPI DEPARTMENT OF NATURAL RESOURCES

Bureau of Land and Water Resources

Southport Mall

P.O. Box 10631

Jackson, Mississippi 39209

WATER WELL DRILLERS LOG

Jackson  
D 2048

9-30-85 date well completed  
Pierce Drilling Co. firm name  
Jackson Co. county well located

LANDOWNER: Hurst Drigden

description of formations encountered

from to

Hurley, Ms.  
(mailing address)

top soil  
Clay  
good Sand

0	10
10	20
20	35

WELL LOCATION:

sec. 3 T 4 N R 5 E  
4 miles west of Natchitoches  
(distance) (direction) (nearest town)

WELL PURPOSE:

(home, irrigation, municipal, industrial)

WELL COMPLETION DATA:

- (1) diameter (inches) 2"
- (2) total depth (feet) 35'
- (3) static water level (feet) 15' below top of ground.
- (4) casing plastic, 30' (material) (depth)  
0 (size) If telescope see back.
- (5) screen 5, 35' (length) (depth to top)  
306, plastic (size) (material)
- (6) pump 1/2, 10 (HP) (yield gpm)  
electric (type power)
- (7) electric log (yes or no)  
(organization running log)
- (8) how well bottom plugged BU

RECEIVED


NOV 19 1985

DRILLERS REMARKS:

Department of Natural Resources  
Bureau of Land & Water Resources

If well telescopes please sketch and show depths.

GROUND LEVEL

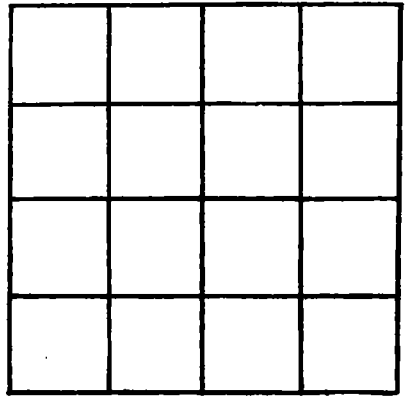

SECTION \_\_\_\_\_

Please indicate well location X.

ADDITIONAL INFORMATION

If more than one screen,  
show locations of each on sketch.