

MISSISSIPPI DEPARTMENT OF NATURAL RESOURCES

Bureau of Land and Water Resources

Southport Mall

P.O. Box 10631

Jackson, Mississippi 39209

WATER WELL DRILLERS LOG

Jackson
D 2049

10-16-85 Fry Fogle Well Serv

JACKSON

date well completed

firm name

county well located

LANDOWNER: Jackson County
School Dist.
3301 Magnolia Street
Pascagoula MS 39567
(mailing address)

description of formations encountered	from	to
Top Soil	0	10
clay + sand	10	20
sand	20	25
clay	25	50
water sand	50	57

WELL LOCATION:

sec. 32 T 4 N R 5 E
1 miles W of Hurley
(distance) (direction) (nearest town)

WELL PURPOSE: Home
(home, irrigation, municipal, industrial)

WELL COMPLETION DATA:

- (1) diameter (inches) 2
- (2) total depth (feet) 57
- (3) static water level (feet) 40 ^{below} _{above} top of ground.
- (4) casing PVC, 50
(material) (depth)
2" (size) If telescope see back.
- (5) screen 7' 50
(length) (depth to top)
2" PVC
(size) (material)
- (6) pump 1 10 GPM
(HP) (yield gpm)
Elect
(type power)
- (7) electric log N
(yes or no)
N
(organization running log)
- (8) how well bottom plugged PVC
Ball check


RECEIVED
NOV 22 1985

Department of Natural Resources
Bureau of Land & Water Resources

DRILLERS REMARKS:

If well telescopes please sketch and show depths.

GROUND LEVEL

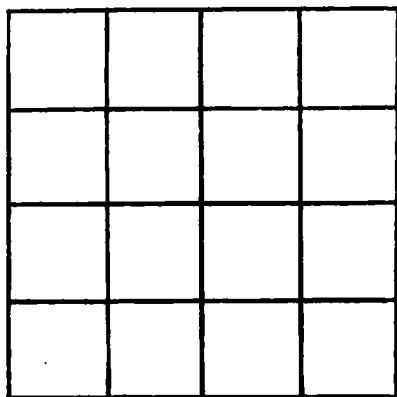

SECTION _____

Please indicate well location X.

ADDITIONAL INFORMATION

If more than one screen, show locations of each on sketch.