

MISSISSIPPI DEPARTMENT OF NATURAL RESOURCES

Bureau of Land and Water Resources

Southport Mall

P.O. Box 10631

Jackson, Mississippi 39209

WATER WELL DRILLERS LOG

JACKSON
D 2050

11-29-1985 date well completed Pierce Drilling firm name Jackson county well located

LANDOWNER: Lavon Scarborough

description of formations encountered	from	to
top soil	0	2
clay	2	25
good sand	25	35

Hurley Ms (mailing address)

WELL LOCATION:

sec 33 T 4 N R 5 E
S W
2 miles south of Hurley (distance) (direction) (nearest town)

WELL PURPOSE:

(home, irrigation, municipal, industrial)

WELL COMPLETION DATA:

- (1) diameter (inches) 2"
- (2) total depth (feet) 35'
- (3) static water level (feet) 15' ^{below} above top of ground.
- (4) casing plastic, 30' (material) (depth)
- 0 (size) if telescope see back.
- (5) screen 5', 35' (length) (depth to top)
- 006, plastic (size) (material)
- (6) pump 1 10 (HP) (yield gpm)
- electric (type power)
- (7) electric log (yes or no)



JAN 06 1986


Department of Resources
Bureau of Land & Water Resources

(organization running log)
(8) how well bottom plugged BW

DRILLERS REMARKS:

If well telescopes please sketch and show depths.

GROUND LEVEL

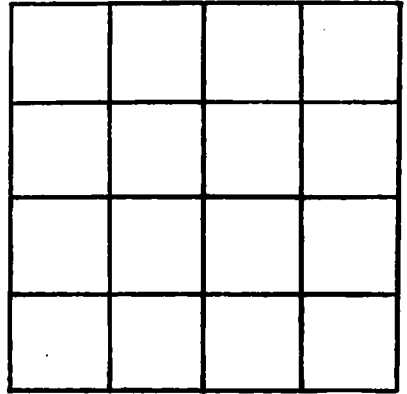

SECTION _____

Please indicate well location X.

ADDITIONAL INFORMATION

If more than one screen, show locations of each on sketch.