

MISSISSIPPI DEPARTMENT OF NATURAL RESOURCES

Bureau of Land and Water Resources

Southport Mall

P.O. Box 10631

Jackson, Mississippi 39209

WATER WELL DRILLERS LOG

JACKSON  
D 2051

12-14 1985 Pierce Drilling Co Jackson  
date well completed firm name county well located

LANDOWNER: EE. Crump

description of formations encountered

from to

19121 Thrasher Dr.

2000 Soil

2-10

Pascagoula, Ms  
(mailing address)

Clay

10-30

WELL LOCATION:

Sand

30-100

sec 3 T 4 N R 5 E  
1/2 miles South of Georgetown  
(distance) (direction) (nearest town)

Clay

100-180

good Sand

180-190

WELL PURPOSE:

(home) irrigation, municipal, industrial

WELL COMPLETION DATA:

(1) diameter (inches) 2"

(2) total depth (feet) 190'

(3) static water level (feet) 30' below top of ground.

(4) casing plastic, 180'  
(material) (depth)

0 if telescope see back.  
(size)

(5) screen 10', 190'  
(length) (depth to top)

006, plastic  
(size) (material)

(6) pump 1 10  
(HP) (yield gpm)

electric  
(type power)

(7) electric log (yes or no)

(organization running log)

(8) how well bottom plugged SW

RECEIVED


JAN 03 1986

Department  
Bureau of Land and Water Resources

DRILLERS REMARKS:

If well telescopes please sketch and show depths.

GROUND LEVEL

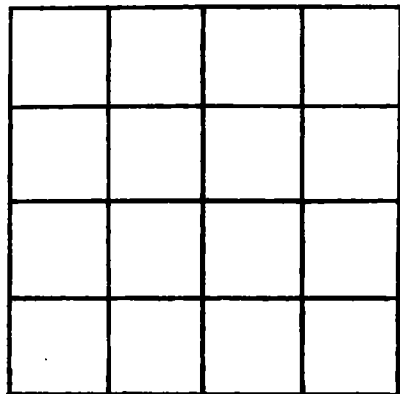

SECTION \_\_\_\_\_

Please indicate well location X.

ADDITIONAL INFORMATION

If more than one screen, show locations of each on sketch.