

MISSISSIPPI DEPARTMENT OF NATURAL RESOURCES

Bureau of Land and Water Resources

Southport Mall

P.O. Box 10631

Jackson, Mississippi 39209

WATER WELL DRILLERS LOG

JACKSON
D 7052

12-30-85 Pierce Drilling Co. Jackson
 date well completed firm name county well located


LANDOWNER: Joe Howard
Hurley-Wade Rd.
Pascagoula, ms
 (mailing address)

description of formations encountered	from	to
top soil	0	10
clay	10	35
good sand	35	70
clay	70	100
good sand	100	120

WELL LOCATION:
 sec. 31 T. 4 N R. 5 E
6 miles South of Norhanta
 (distance) (direction) (nearest town)

WELL PURPOSE:
 (home, irrigation, municipal, industrial)

- WELL COMPLETION DATA:
- (1) diameter (inches) 2"
 - (2) total depth (feet) 120'
 - (3) static water level (feet) 4' below above top of ground.
 - (4) casing plastic 115'
 (material) (depth)
 - 0 If telescope see back.
 (size)
 - (5) screen 5' 120'
 (length) (depth to top)
 - 006 plastic
 (size) (material)
 - (6) pump 1 12
 (HP) (yield gpm)
 - electric
 (type power)
 - (7) electric log (yes or no)
 (organization running log)
 - (8) how well bottom plugged BW

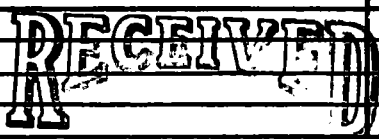


JAN 02 1986

Department of Natural Resources
 Bureau of Land & Water Resources

DRILLERS REMARKS:

If well telescopes please sketch and show depths.

GROUND LEVEL

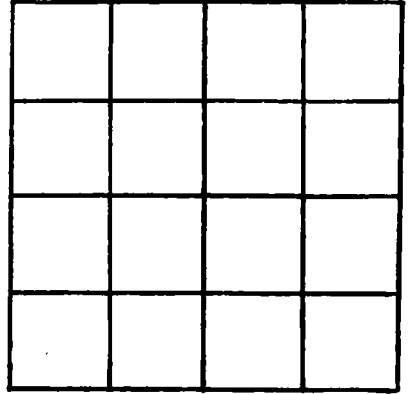

SECTION _____

Please indicate well location X.

ADDITIONAL INFORMATION

If more than one screen, show locations of each on sketch.