

MISSISSIPPI DEPARTMENT OF NATURAL RESOURCES

Bureau of Land and Water Resources

Southport Mall

P.O. Box 10631

Jackson, Mississippi 39209

WATER WELL DRILLERS LOG

Jackson
D 2053

2-4-86
date well completed

19 Jayhawk well
firm name

Jackson
county well located

LANDOWNER: Melvin Mason

description of formations encountered

from to

Narlston, MS
(mailing address)

TOP Soil	0	5
Clay	5	10
Fine sand	10	15
Strip of Sand & clay	15	29
sand	29	35

WELL LOCATION:

sec. 1 T. 4 N. R. 5 E
 1 miles S of Narlston
 (distance) (direction) (nearest town)

WELL PURPOSE: Home
 (home, irrigation, municipal, industrial)

WELL COMPLETION DATA:

- (1) diameter (inches) 2"
- (2) total depth (feet) 35'
- (3) static water level (feet) 31 below top of ground.
- (4) casing PVC, 31 (material), (depth)
- N If telescope see back.
(size)
- (5) screen 4, 31 (length), (depth to top)
- 2", PVC (size), (material)
- (6) pump 1, 10 (HP), (yield gpm)
- E (type power)
- (7) electric log N (yes or no)
- N (organization running log)
- (8) how well bottom plugged. PVC
ball check


RECEIVED
MAR 19 1986

DRILLERS REMARKS:

Department of Natural Resources
Bureau of Land & Water Resources

If well telescopes please sketch and show depths.

GROUND LEVEL

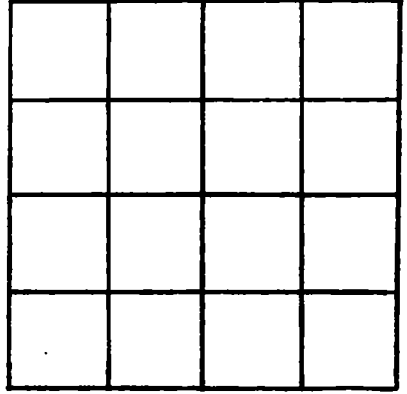

SECTION _____

Please indicate well location X.

ADDITIONAL INFORMATION

If more than one screen, show locations of each on sketch.