

JACKSON  
D 2054

MISSISSIPPI  
BOARD OF WATER COMMISSIONERS  
416 North State Street  
Jackson, Mississippi 39201

WATER WELL DRILLERS LOG

2-26 1986 Pierce Drilling Co. Jackson  
date well completed firm name county well located

LANDOWNER: Johnny Naremski

description of formations encountered	depth	
	from	to
<u>Top Soil</u>	<u>0</u>	<u>10</u>
<u>Sand &amp; Clay</u>	<u>10</u>	<u>20</u>
<u>Good Sand</u>	<u>20</u>	<u>42</u>
		<u>43</u>

Hurley, Ms  
(mailing address)

WELL LOCATION:  
sec. 30 T 4 N R 5 E  
1 miles North of Hurley  
(distance) (direction) (nearest town)

WELL PURPOSE:  
(Home, Irrigation, municipal, industrial)

WELL COMPLETION DATA:

- (1) diameter (inches) 2"
- (2) total depth (feet) 42' 43"
- (3) static water level (feet) 18' below top of ground.
- (4) casing plastic, 38' (material) (depth)  
0 (size) if telescope see back.
- (5) screen 5', 42' 43" (length) (depth to top)  
006, plastic (size) (material)
- (6) pump 1 (HP), 12 (yield gpm)  
electric (type power)
- (7) electric log (yes or no)

42'  
47'  
39'  
43'

(organization running log)

(8) how well bottom plugged BLW

DRILLERS REMARKS:


RECEIVED

MAR 19 1986

Department of Natural Resources  
Bureau of Land & Water Resources

If well telescopes please sketch and show depths.

GROUND LEVEL

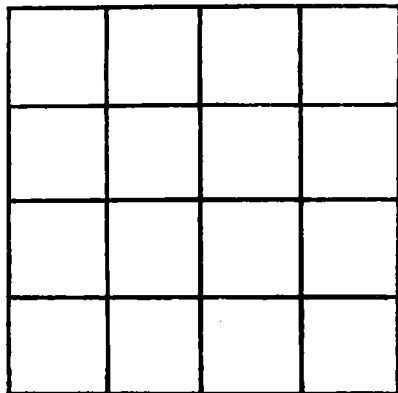

SECTION \_\_\_\_\_

Please indicate well location X.

ADDITIONAL INFORMATION

If more than one screen,  
show locations of each on sketch.