

MISSISSIPPI DEPARTMENT OF NATURAL RESOURCES

Bureau of Land and Water Resources

Southport Mall

P.O. Box 10631

Jackson, Mississippi 39209

WATER WELL DRILLERS LOG

Jackson  
D7055

3-24  
date well completed

Bo Peice Drilling Co.  
firm name

Jackson  
county well located

LANDOWNER: Donald Harmon

description of formations encountered

from

to

Hurley, MS  
(mailing address)

<u>top soil</u>	<u>0</u>	<u>10</u>
<u>clay</u>	<u>10</u>	<u>20</u>
<u>good sand</u>	<u>20</u>	<u>45</u>

WELL LOCATION:

sec. 32 T. 4 N. R. 5 E.  
2 miles West of Hurley  
(distance) (direction) (nearest town)

WELL PURPOSE:

(home, irrigation, municipal, industrial)

WELL COMPLETION DATA:

- (1) diameter (inches) 2"
- (2) total depth (feet) 45
- (3) static water level (feet) 10' <sup>below</sup> above top of ground.
- (4) casing plastic, 40,  
(material) (depth)  
0 If telescope see back.  
(size)
- (5) screen 5', 45'  
(length) (depth to top)
- 006, plastic  
(size) (material)
- (6) pump 1, 10  
(HP) (yield gpm)
- electric  
(type power)
- (7) electric log                       
(yes or no)

(organization running log)

(8) how well bottom plugged BW


DRILLERS REMARKS:                     

**RECEIVED**  
MAY 14 1966

Department of Natural Resources  
Bureau of Land & Water Resources

If well telescopes please sketch and show depths.

GROUND LEVEL

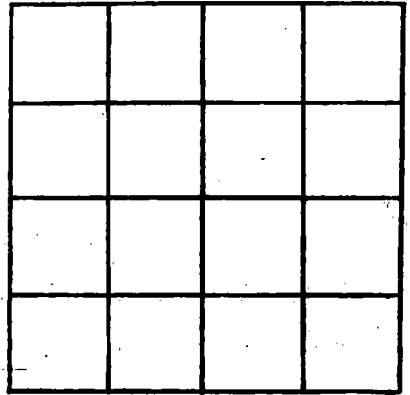

SECTION \_\_\_\_\_

Please indicate well location X.

ADDITIONAL INFORMATION

If more than one screen,  
show locations of each on sketch.