

JACKSON  
D 2036

MISSISSIPPI  
BOARD OF WATER COMMISSIONERS  
416 North State Street  
Jackson, Mississippi 39201

WATER WELL DRILLERS LOG

5-18 1986 Pierce Drilling Co. Jackson  
date well completed firm name county well located

LANDOWNER: Raymond Jarner  
Herkston

description of formations encountered	depth	
	from	to
top soil	0	5
clay	5	15
sand good	15	40

Pascagoula Ms  
(mailing address)

WELL LOCATION:  
sec. 7 T. 4 N R. 5 E  
17 miles South of Lucedale  
(distance) (direction) (nearest town)

WELL PURPOSE:  
(home, irrigation, municipal, industrial)

- WELL COMPLETION DATA:
- (1) diameter (inches) 2"
  - (2) total depth (feet) 40'
  - (3) static water level (feet) 20' below top of ground.
  - (4) casing plastic 35' (material) (depth)
  - (5) screen 5' 40' (length) (depth to top)
  - (6) pump 1 (HP) 10 (yield gpm)
  - (7) electric log (yes or no) no
  - (8) how well bottom plugged BW


DRILLERS REMARKS:

RECEIVED  
AUG 11 1986

Department of Environmental and Natural Resources  
Bureau of Water and Waste Resources

If well telescopes please sketch and show depths.

GROUND LEVEL

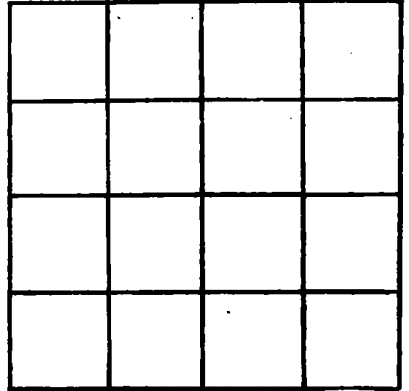

SECTION \_\_\_\_\_

Please indicate well location X.

ADDITIONAL INFORMATION

If more than one screen, show locations of each on sketch.