

**MISSISSIPPI
BOARD OF WATER COMMISSIONERS**
416 North State Street
Jackson, Mississippi 39201

WATER WELL DRILLERS LOG

7-7 1986 Pierce Milling Co Jackson
date well completed firm name county well located

LANDOWNER: Johnny Noremoe
Harleston
Pasc. Ms
(mailing address)

description of formations encountered	depth	
	from	to
<u>top soil</u>	<u>0</u>	<u>10</u>
<u>clay</u>	<u>10</u>	<u>20</u>
<u>good sand</u>	<u>20</u>	<u>35</u>

WELL LOCATION:
sec. 7 T. 4 N. R. 5 E.
1 miles South of Harleston
(distance) (direction) (nearest town)

WELL PURPOSE:
(home, irrigation, municipal, industrial)

- WELL COMPLETION DATA:**
- (1) diameter (inches) 2 1/4
 - (2) total depth (feet) 35
 - (3) static water level (feet) 18' below above top of ground.
 - (4) casing plastic, 30'
(material) (depth)
0 (size) if telescope see back.
 - (5) screen 5', 35'
(length) (depth to top)
006, plastic
(size) (material)
 - (6) pump 1, 10
(HP) (yield gpm)
electric
(type power)
 - (7) electric log yes or no
(organization running log)
 - (8) how well bottom plugged BW


RECEIVED
AUG 11 1986

DRILLERS REMARKS:

Department of Natural Resources
Bureau of Land & Water Resources

If well telescopes please sketch and show depths.

GROUND LEVEL

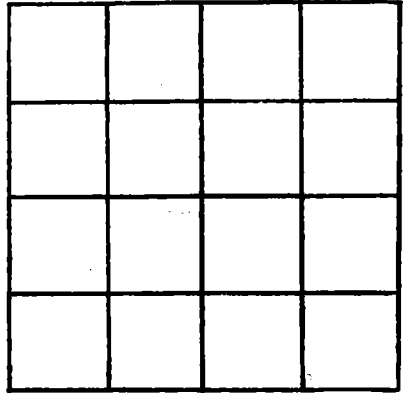

SECTION _____

Please indicate well location X.

ADDITIONAL INFORMATION

If more than one screen,
show locations of each on sketch.